

A

B

C


D

A

B

C

D

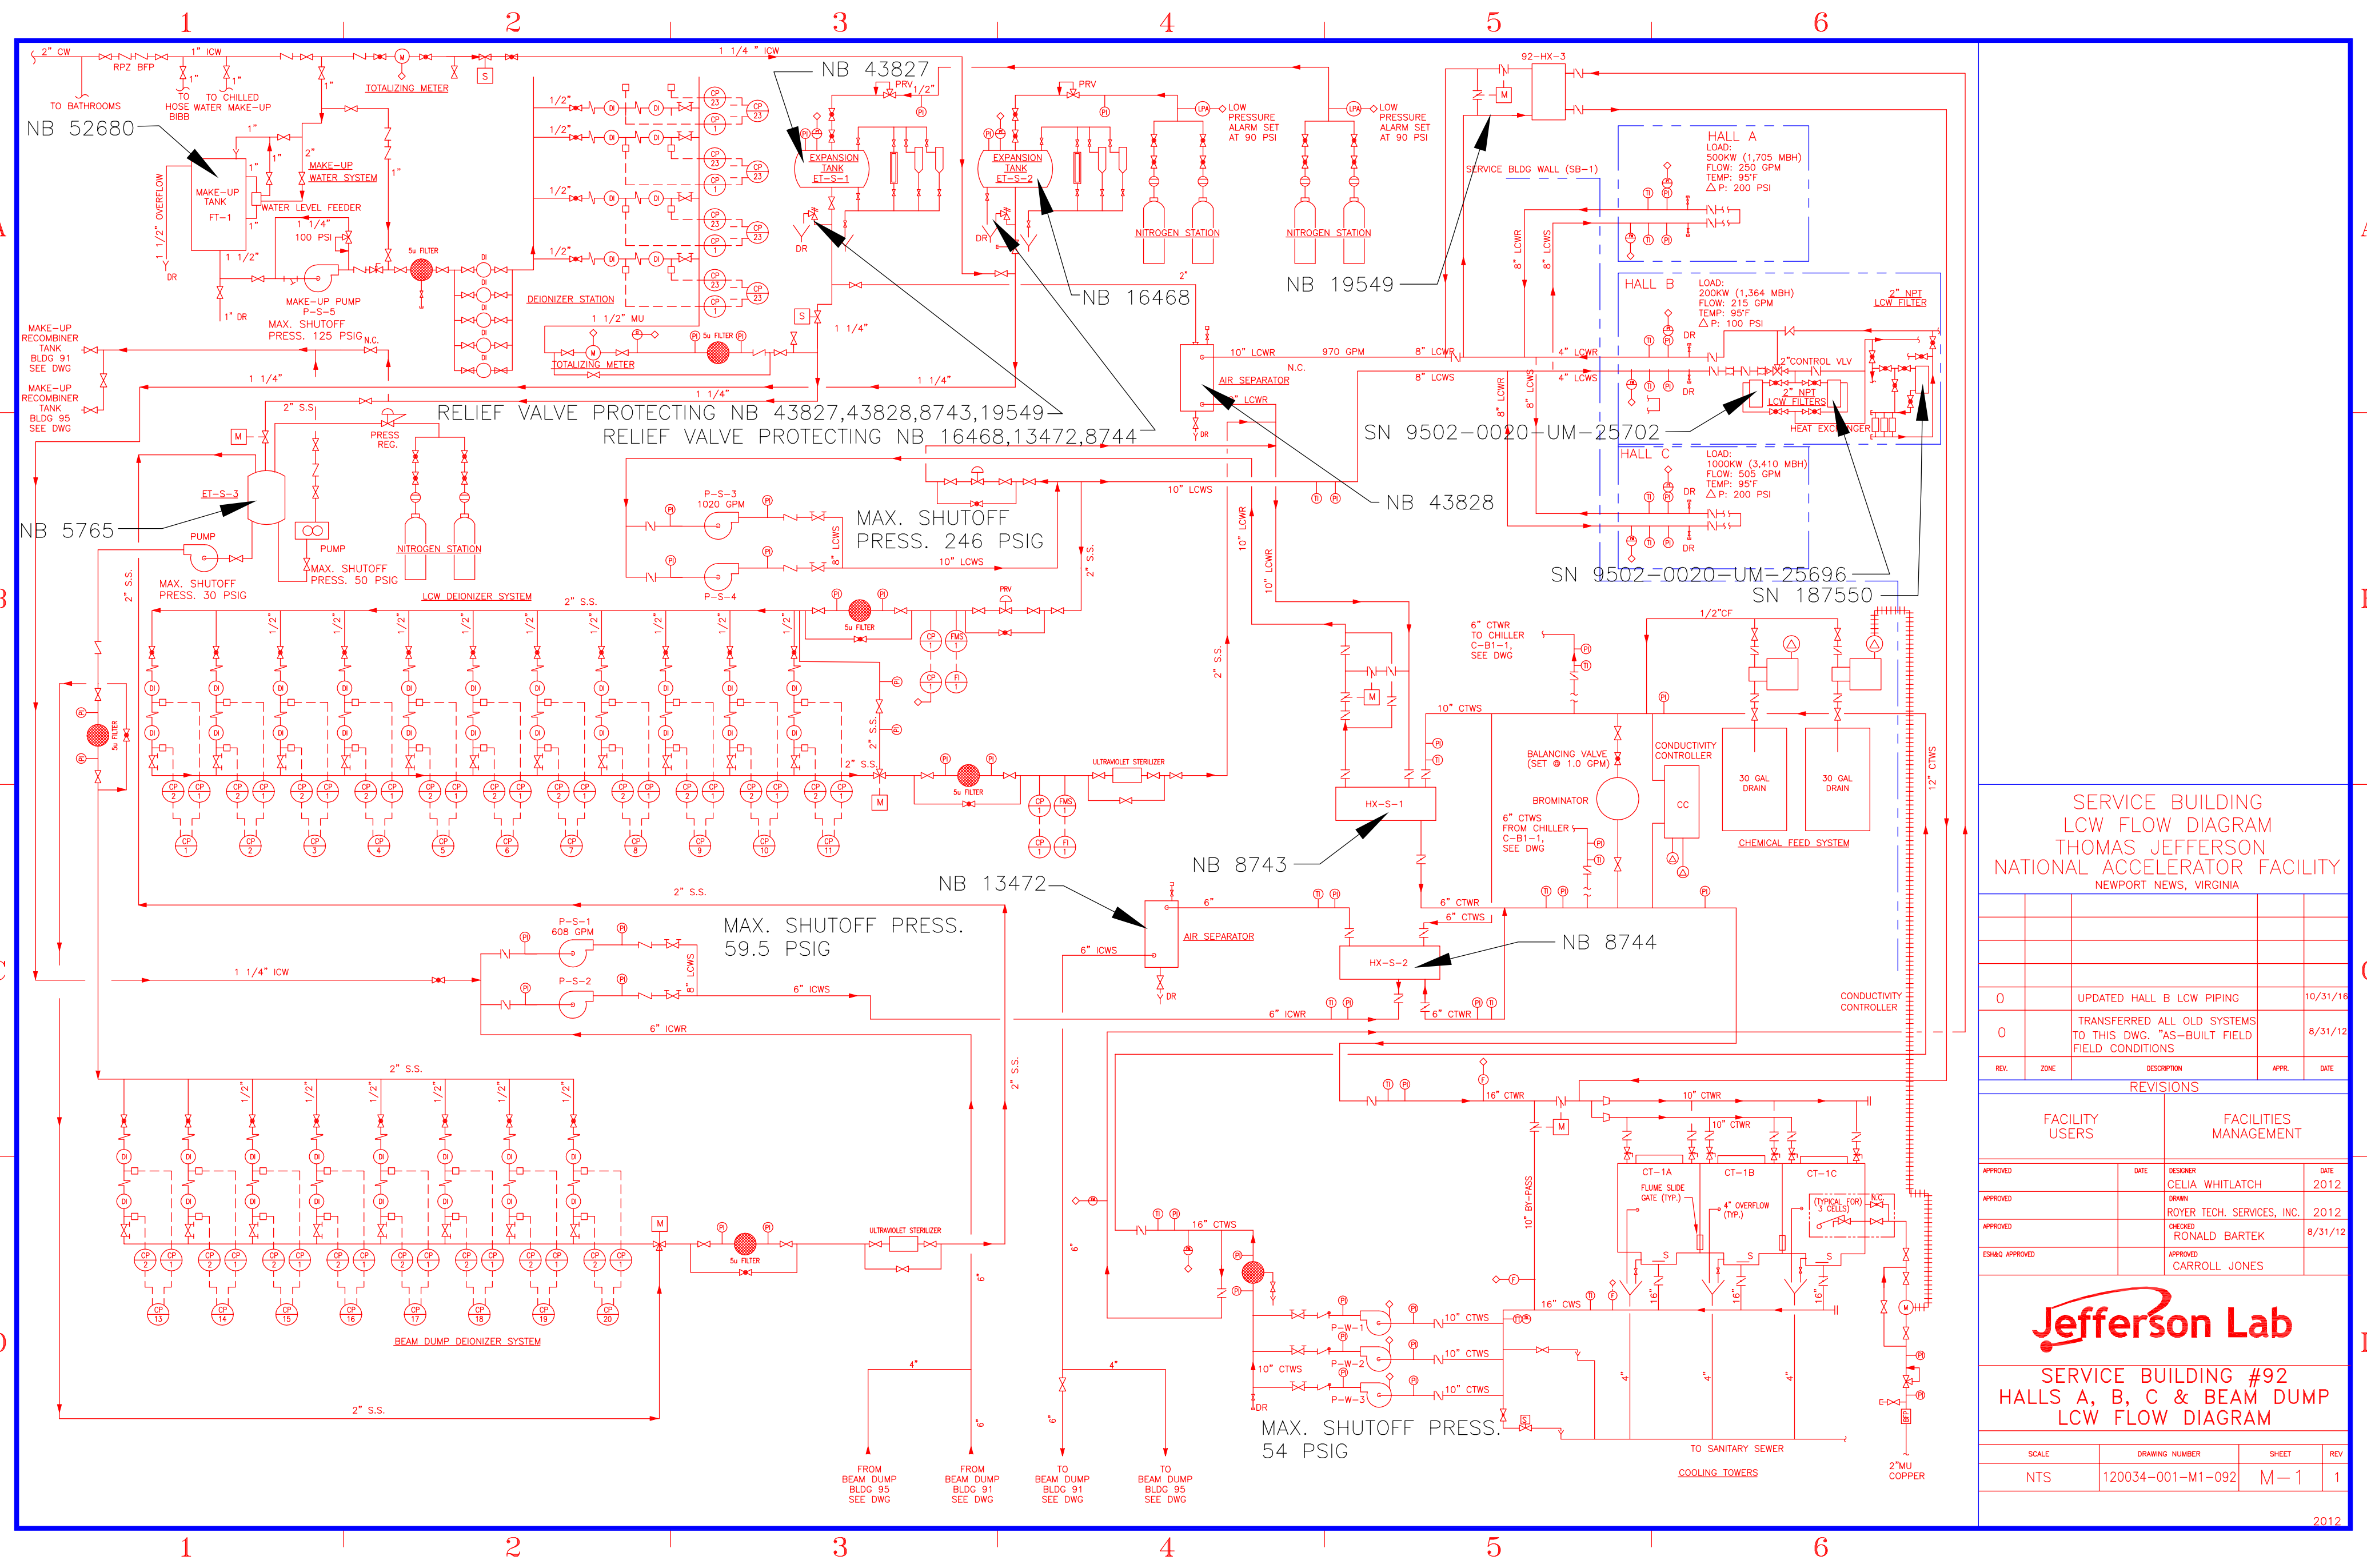

SERVICE BUILDING
LCW FLOW DIAGRAM
THOMAS JEFFERSON
NATIONAL ACCELERATOR FACILITY
NEWPORT NEWS, VIRGINIA

REV.	ZONE	DESCRIPTION	APPR.	DATE
0		UPDATED HALL B LCW PIPING		10/31/16
0		TRANSFERRED ALL OLD SYSTEMS TO THIS DWG. "AS-BUILT FIELD CONDITIONS"		8/31/12

REVISIONS			
FACILITY USERS		FACILITIES MANAGEMENT	
APPROVED	DATE	DESIGNER	DATE
APPROVED		ROYER TECH. SERVICES, INC.	2012
APPROVED		CHECKED	8/31/12
ESHAQ APPROVED		APPROVED	

Jefferson Lab

SERVICE BUILDING #92
HALLS A, B, C & BEAM DUMP
LCW FLOW DIAGRAM

SCALE	DRAWING NUMBER	SHEET	REV
NTS	120034-001-M1-092	M-1	1