
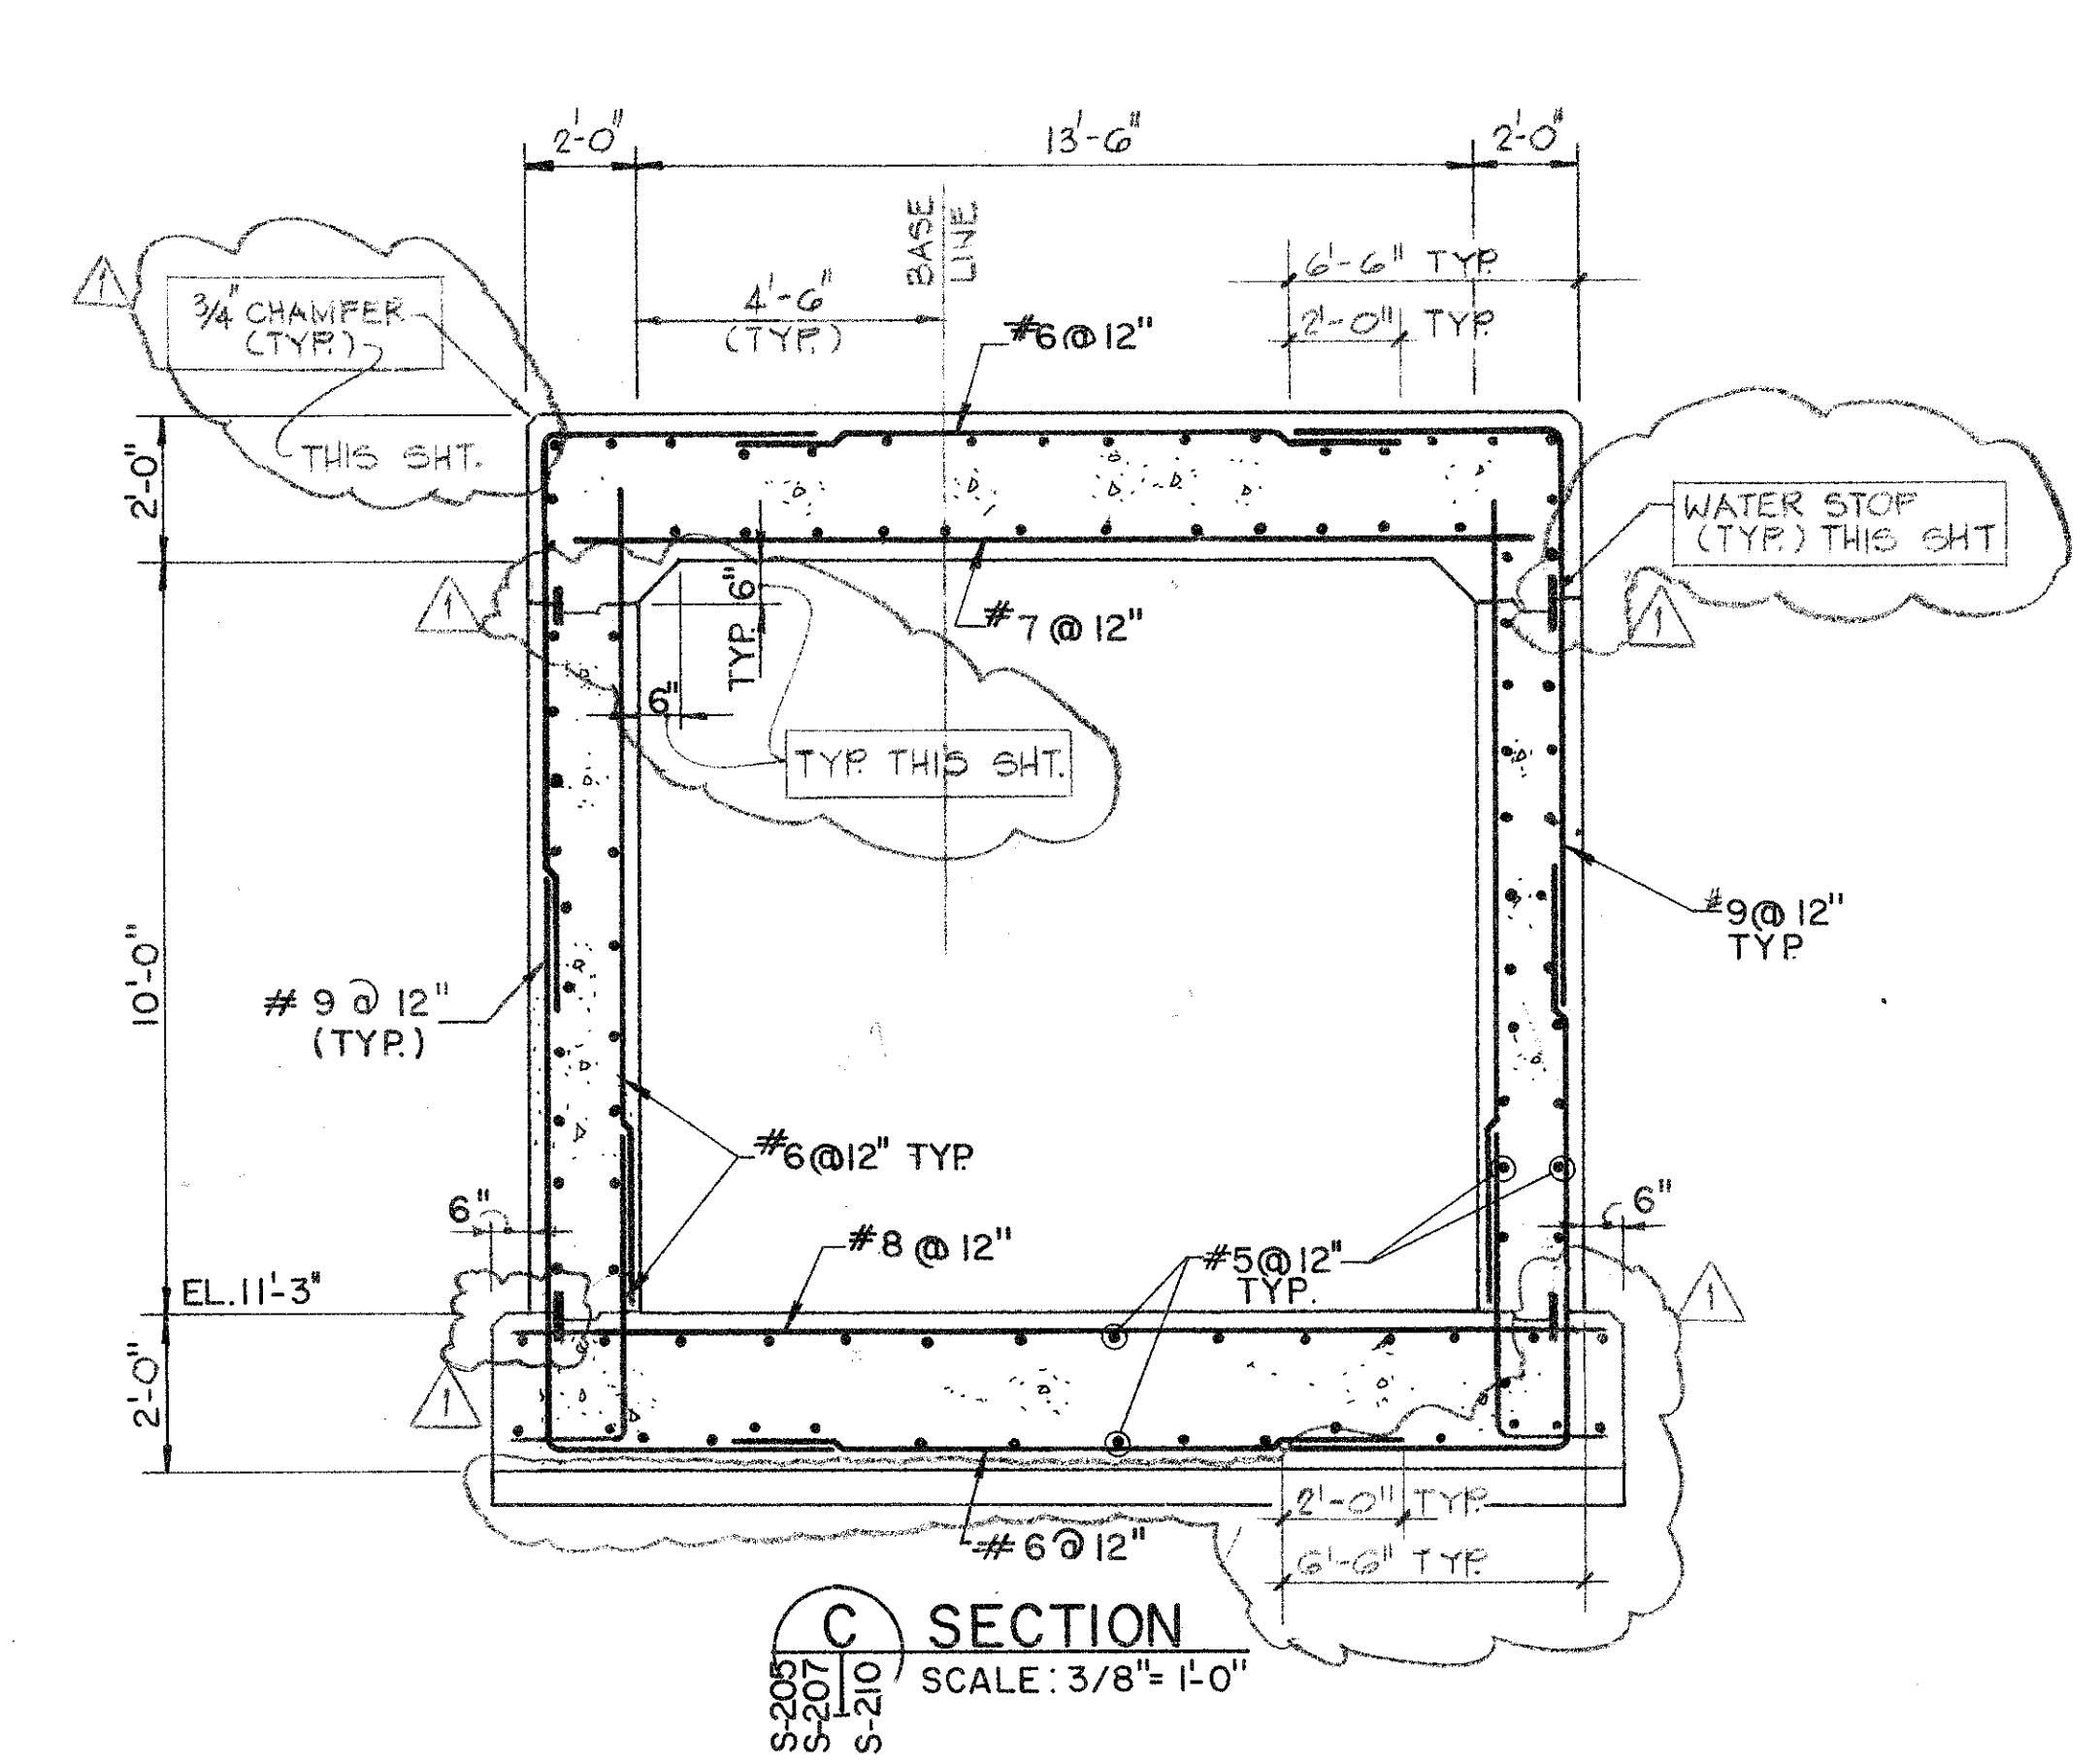
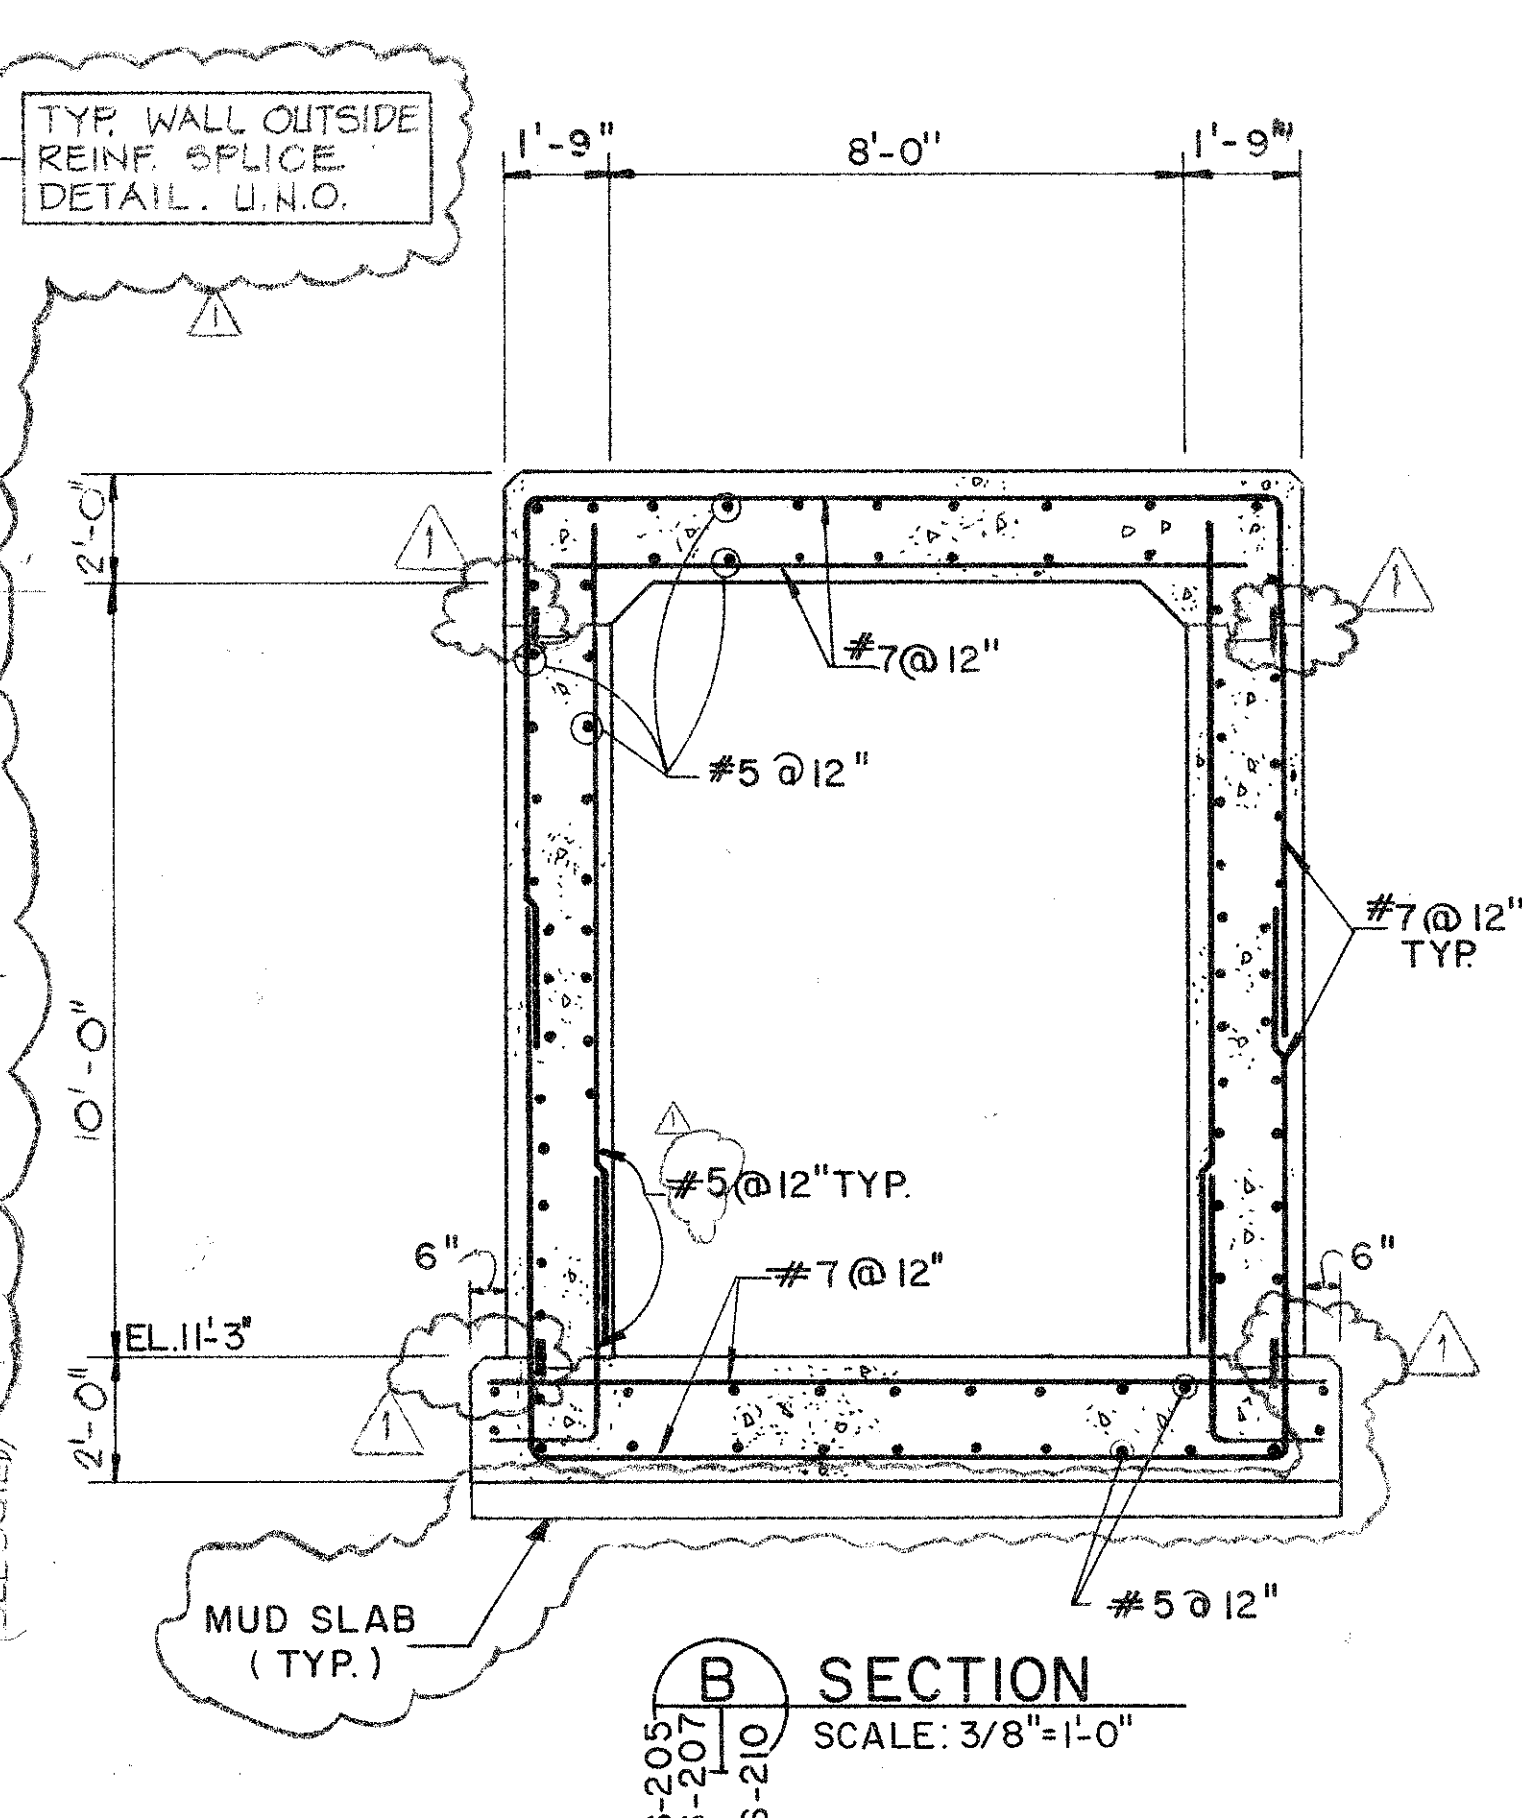




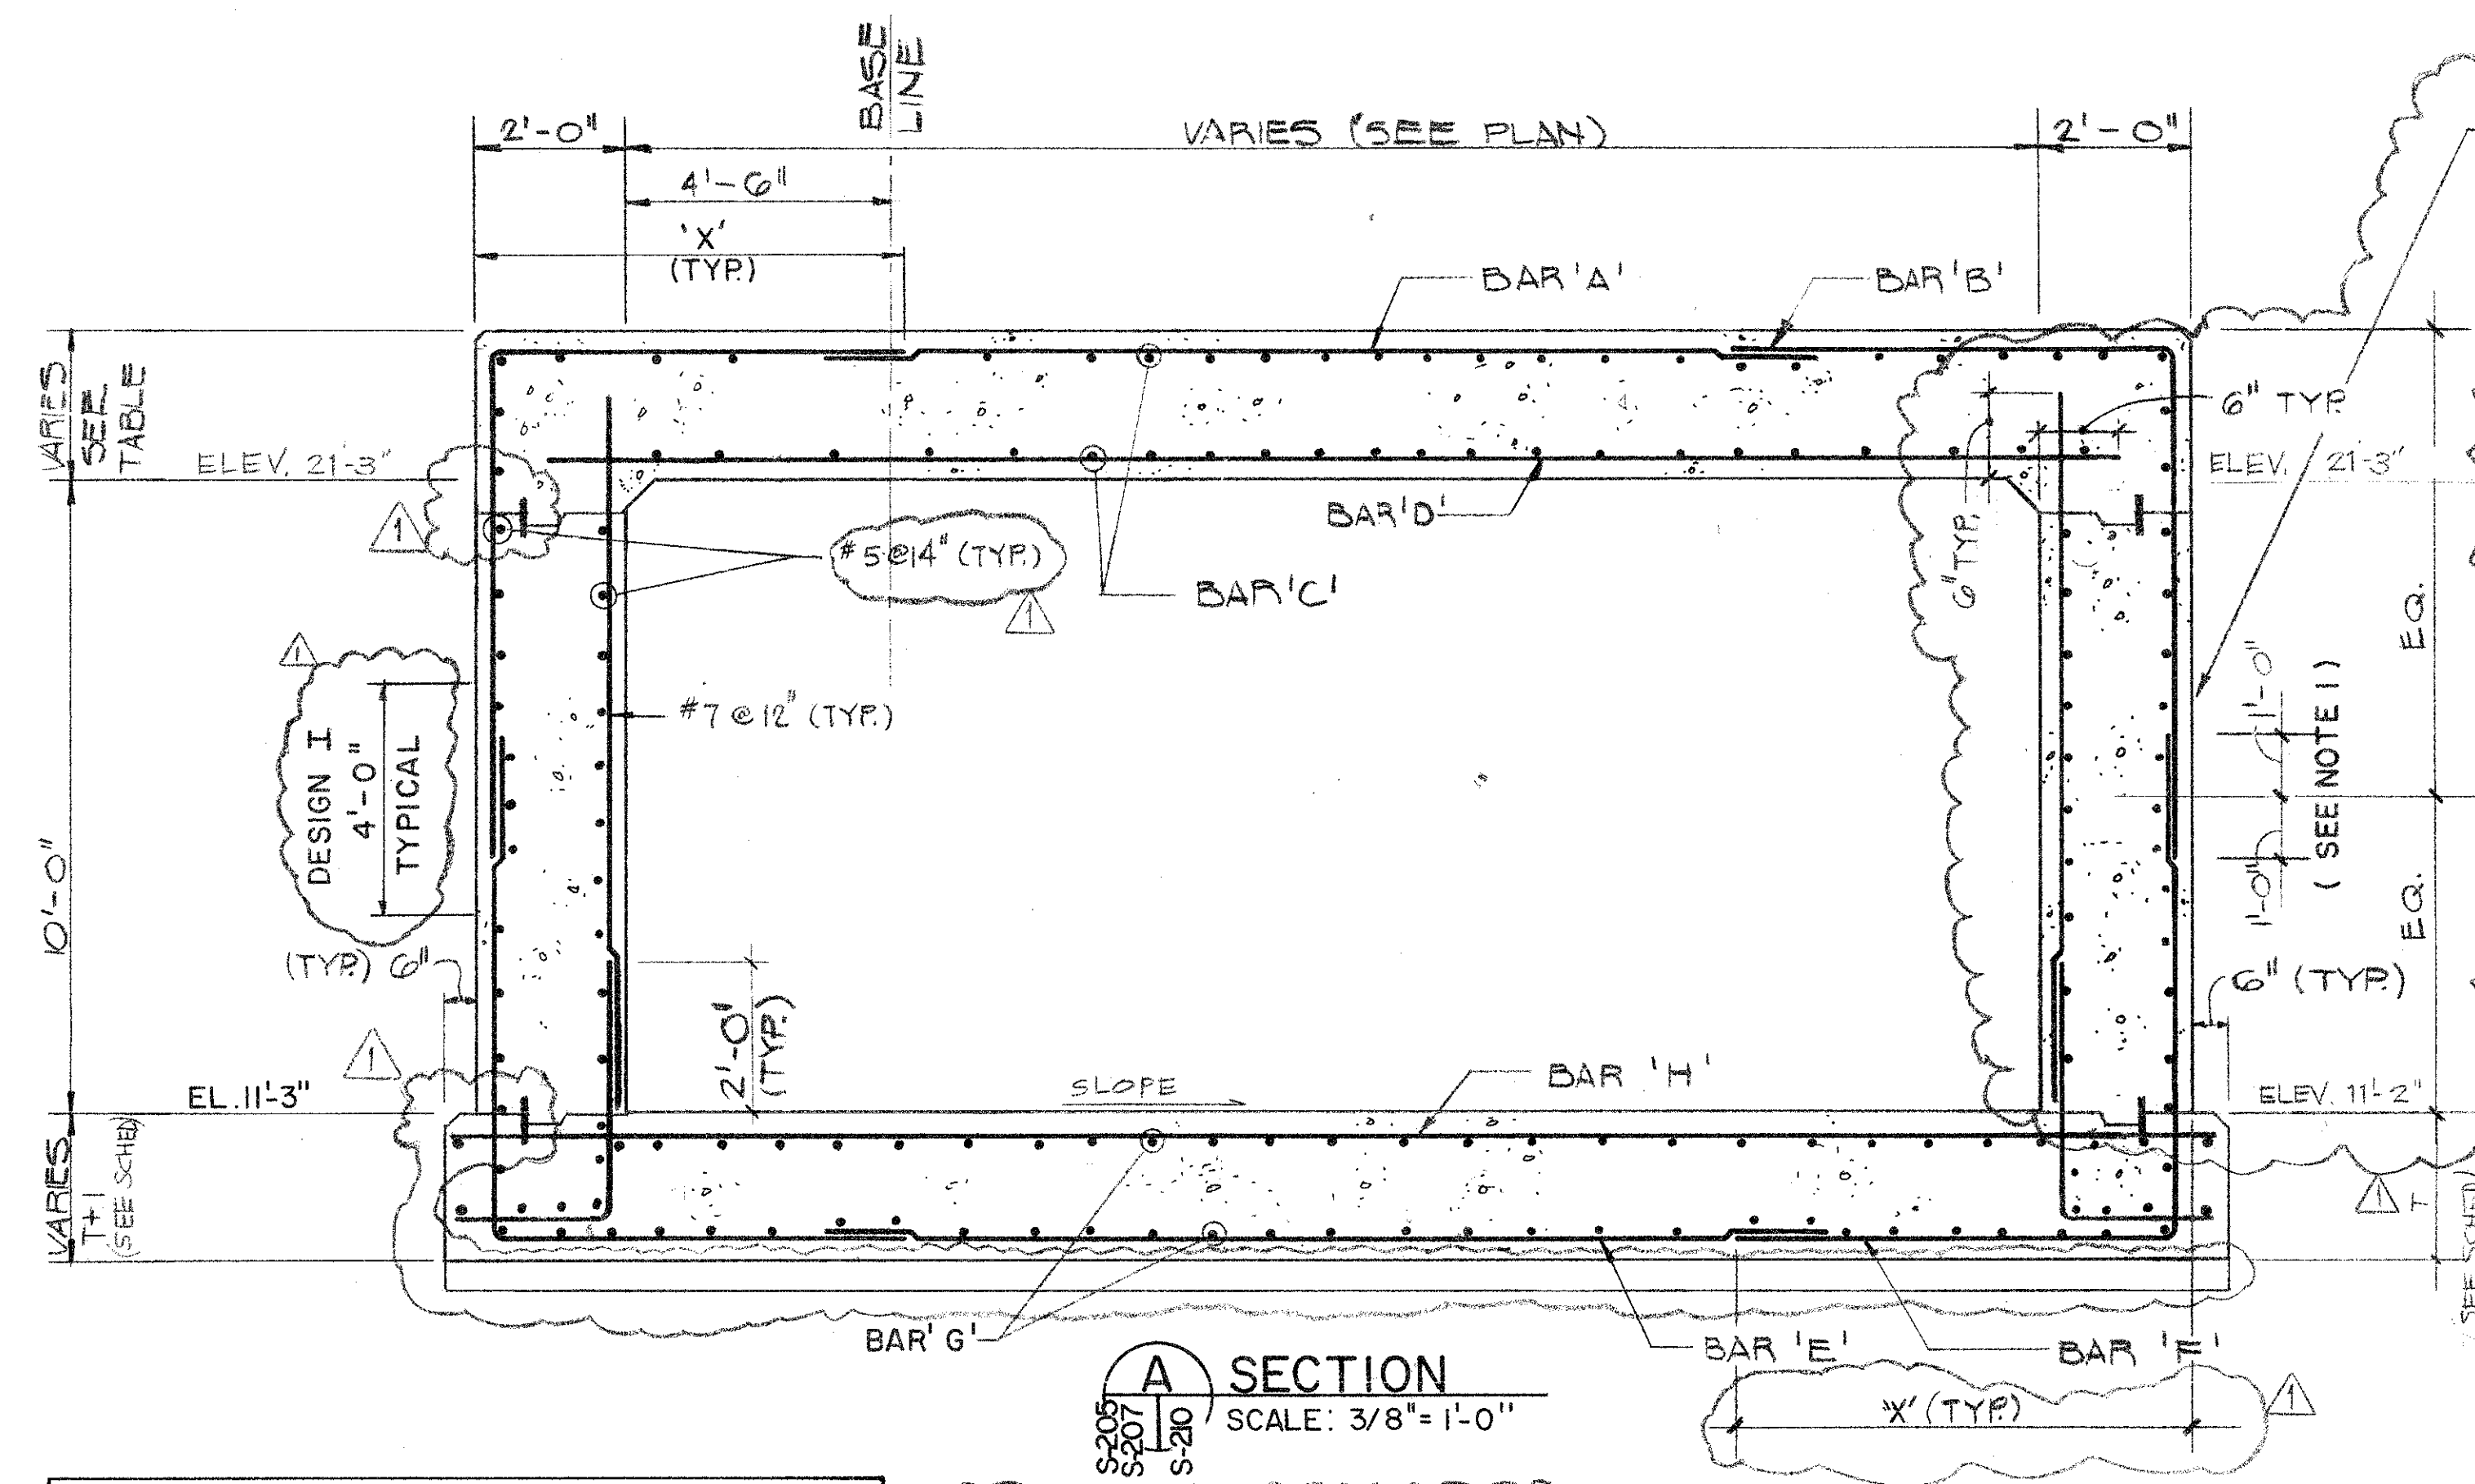


REBAR SCHEDULE FOR SECTION-A			
DIM. 'X'	DESIGN I	DESIGN II	DESIGN III
T.SLAB (t)	3'-0"	3'-0"	2'-0"
B.SLAB (b)	4'-10"	4'-0"	3'-0"
BAR 'A'	#6 @ 12"	#6 @ 12"	#5 @ 12"
BAR 'B'	#9 @ 12"	#8 @ 12"	#9 @ 12"
BAR 'C'	#6 @ 12"	#6 @ 12"	#5 @ 14"
BAR 'D'	#10 @ 6"	#10 @ 12"	#9 @ 12"
BAR 'E'	#7 @ 12"	#7 @ 12"	#6 @ 12"
BAR 'F'	#10 @ 12"	#10 @ 12"	#8 @ 12"
BAR 'G'	#7 @ 12"	#7 @ 12"	#6 @ 12"
BAR 'H'	#11 @ 6"	#10 @ 6"	#10 @ 12"

NOTE: BARS 'C' & 'G' ARE "LONGITUDINAL" REINF. ALL OTHERS ARE "TRANSVERSE" REINF.

NOTE:
I. TYP. WALL OUTSIDE REINF. SPLICE U.N.O.


NOTE: SEE SECTION A THIS SHT. FOR TYP REINF BAR DEVELOPMENTS, SPLICES + DISCONTINUITIES NOT OTHERWISE SHOWN ON THIS SHT.

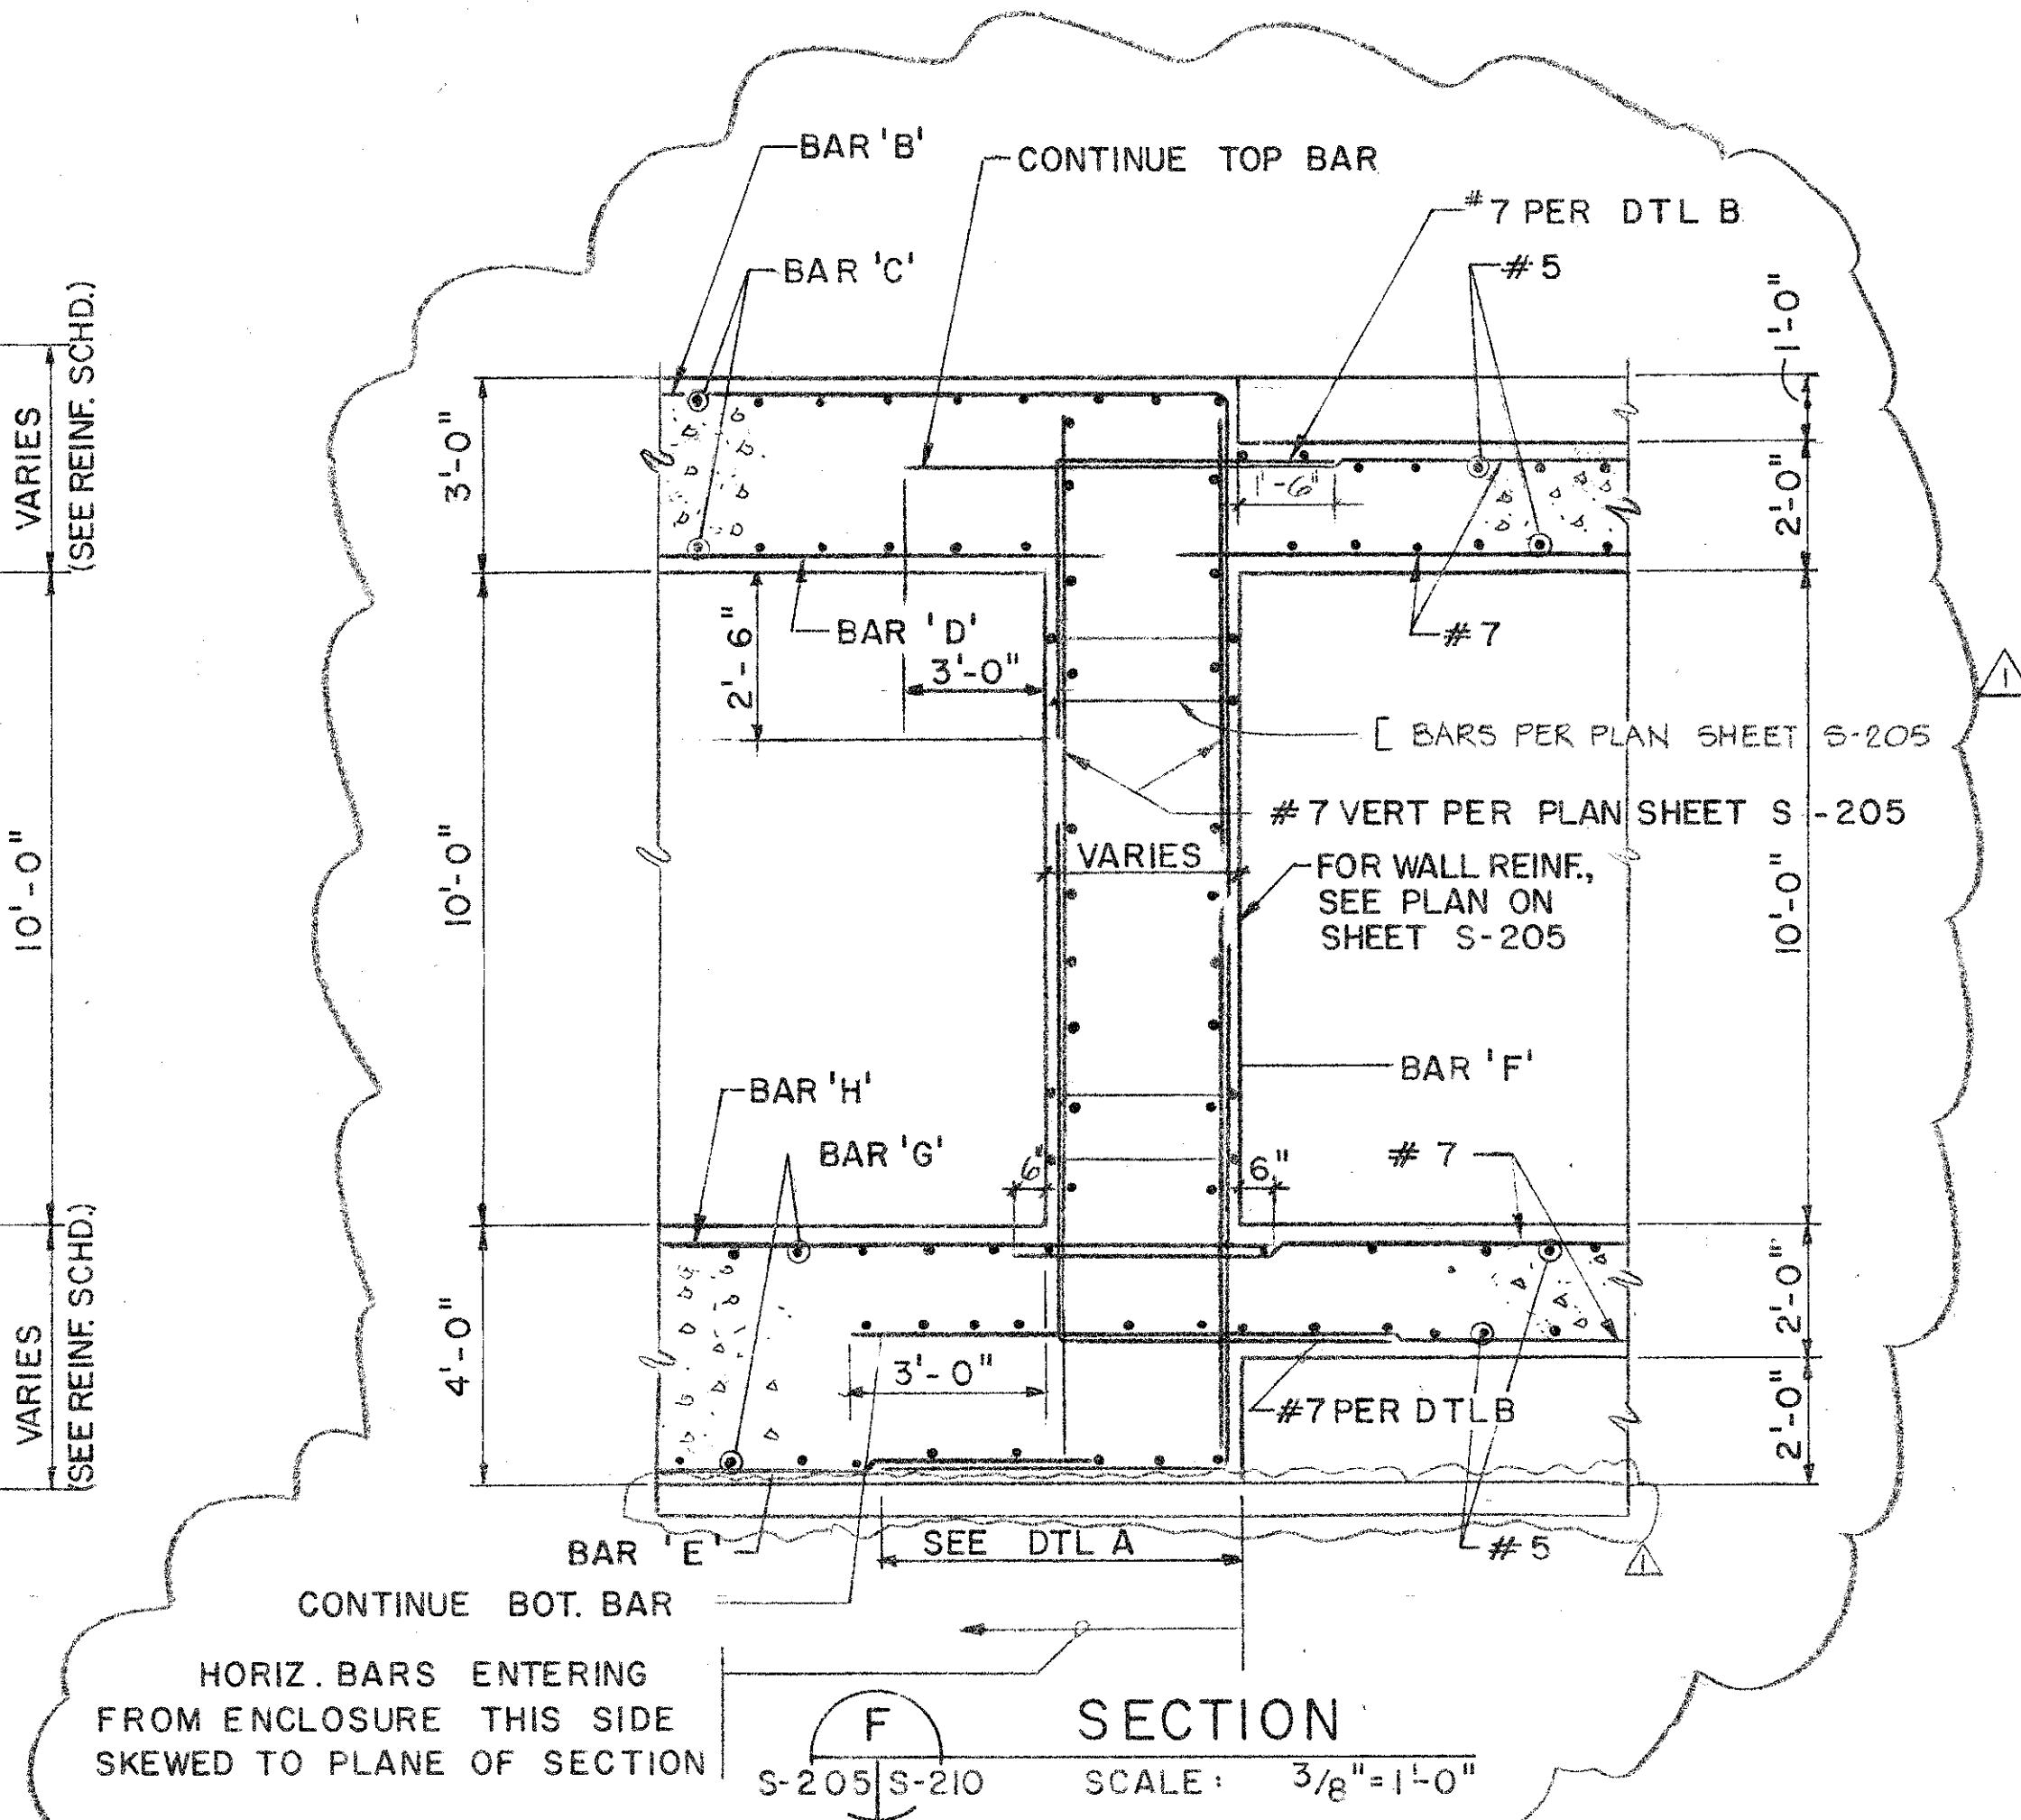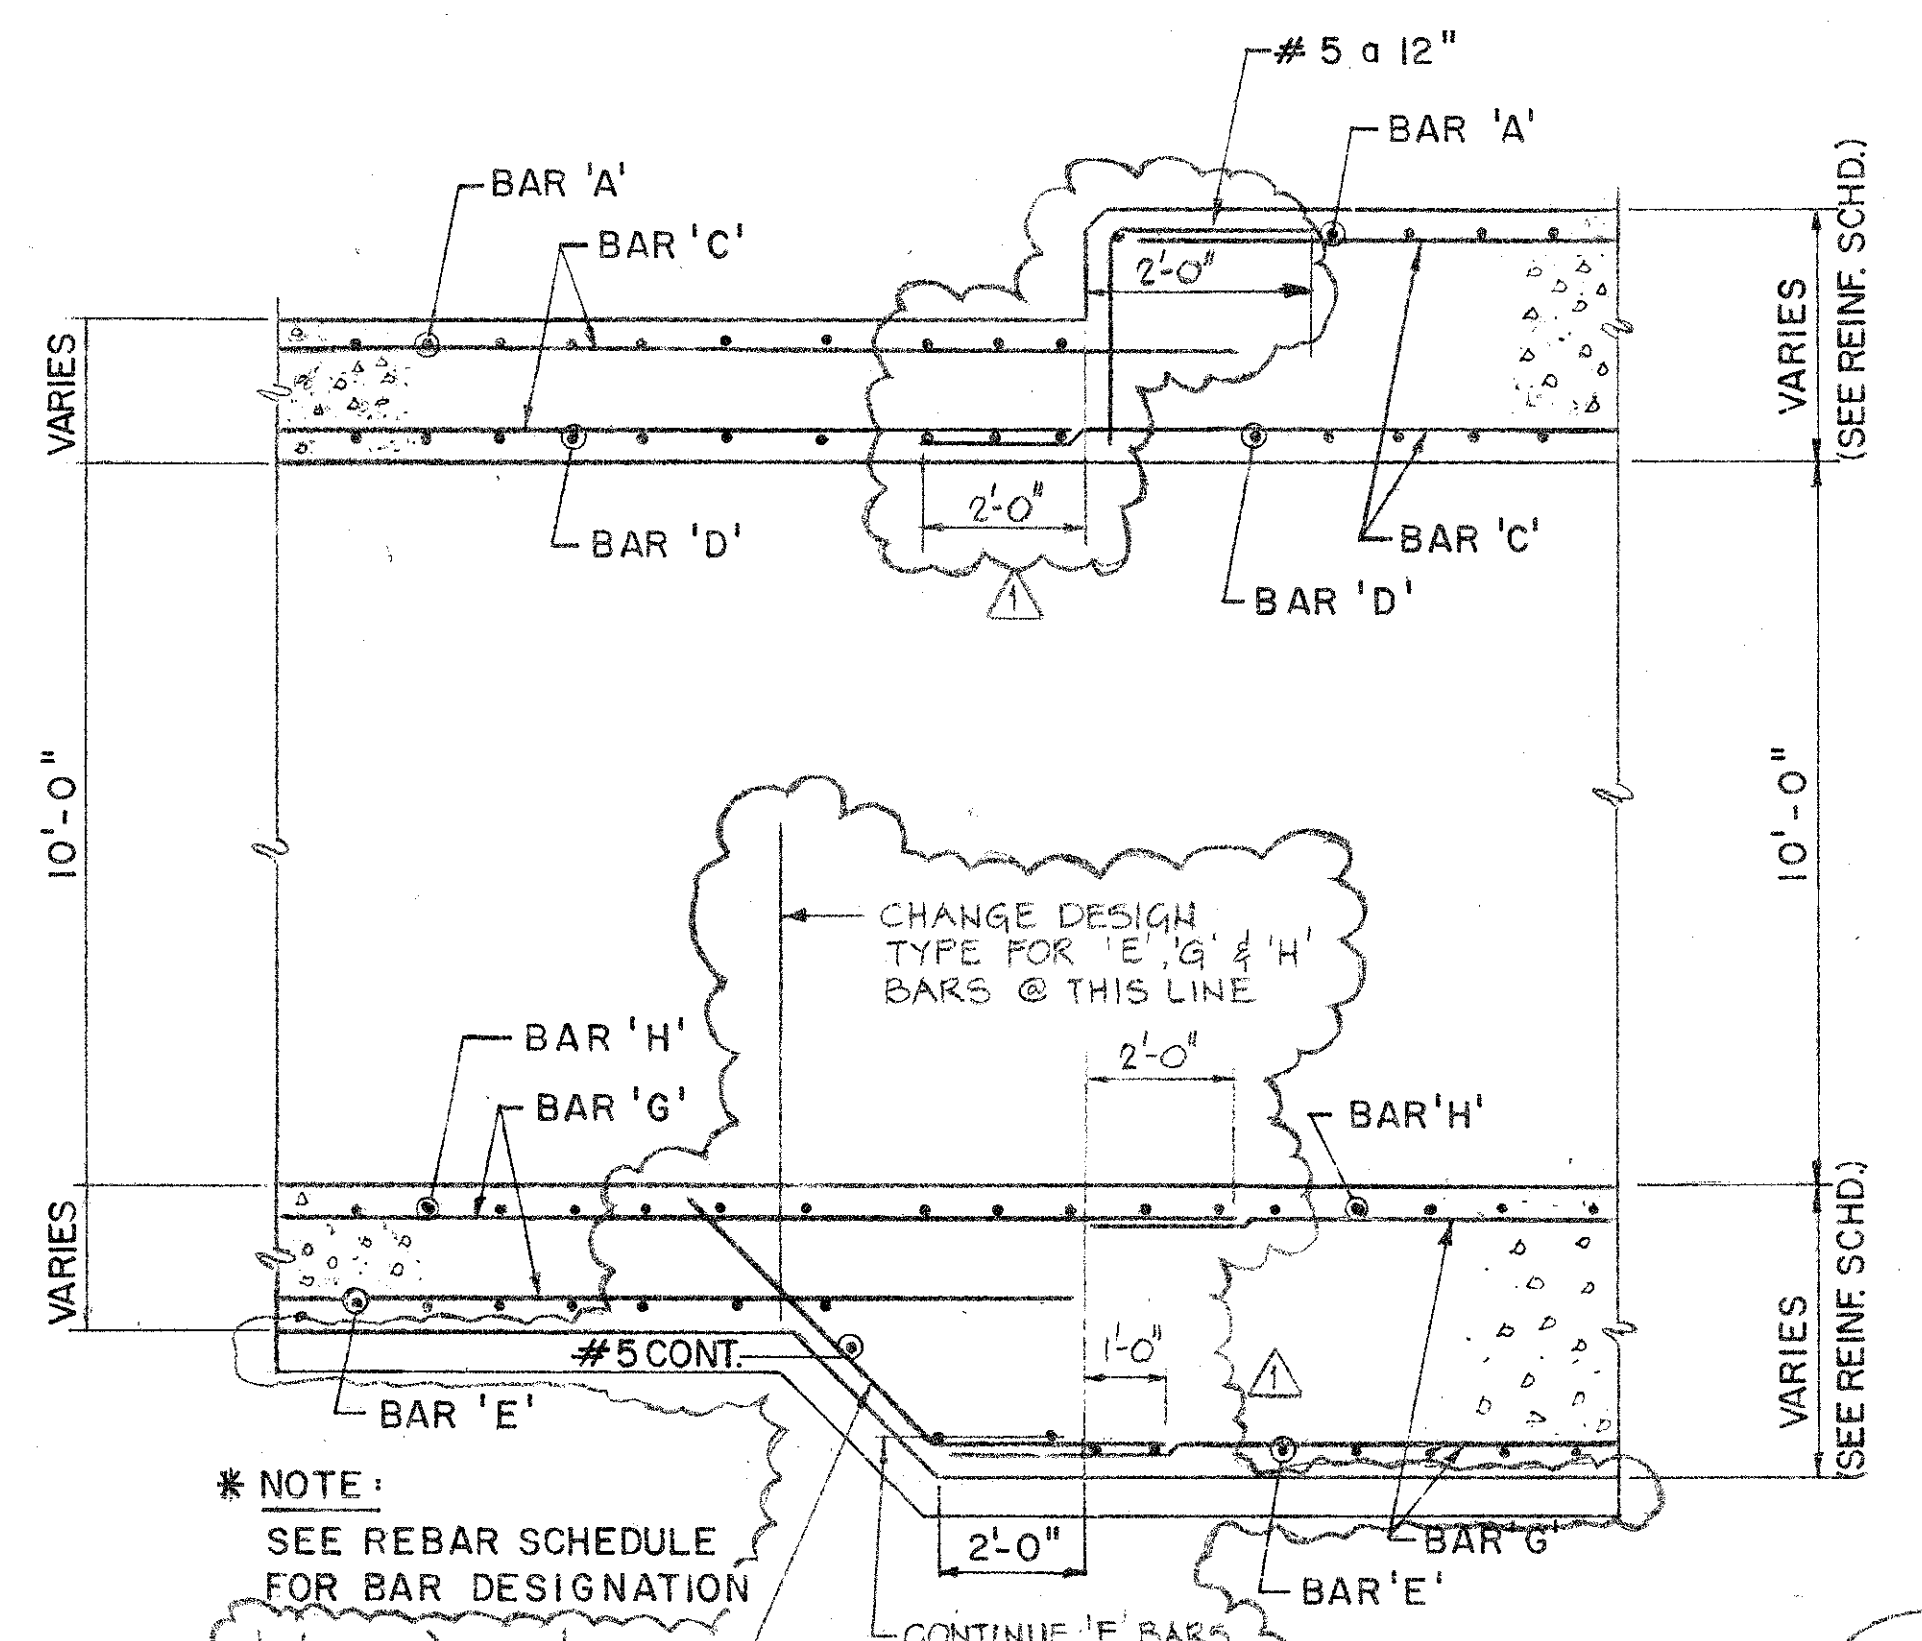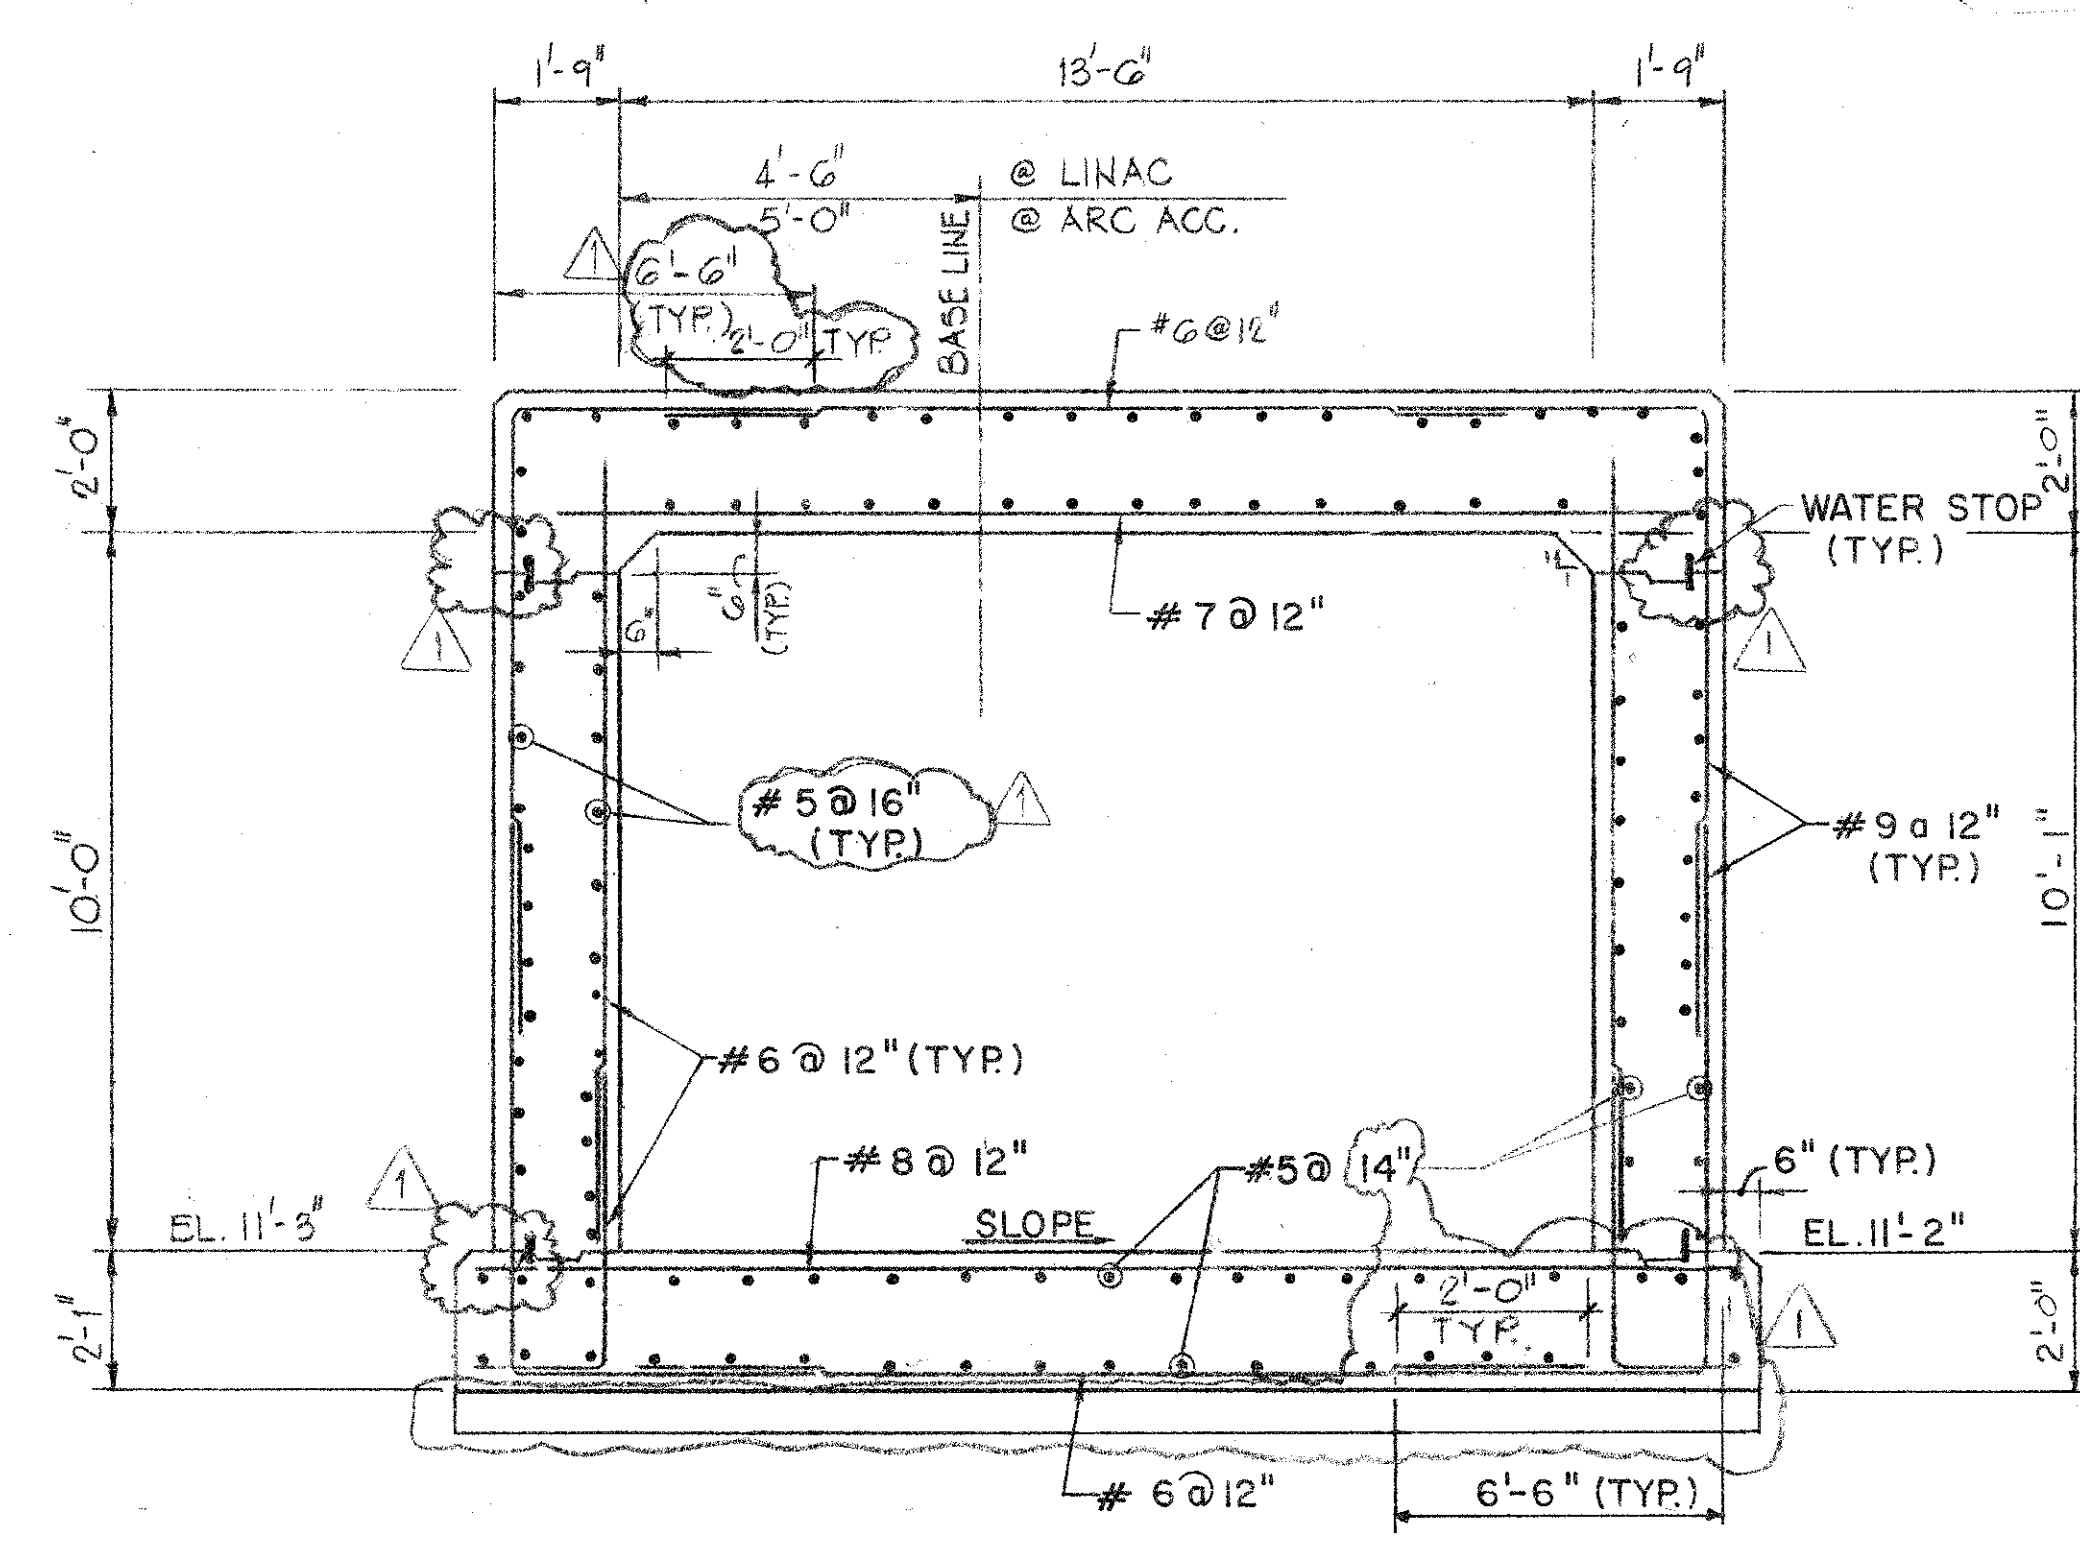

D SECTION
SCALE: 3/8"=1'-0"
TYP. BOX SECTION

E SECTION
SCALE: 3/8"=1'-0"

F SECTION
SCALE: 3/8"=1'-0"

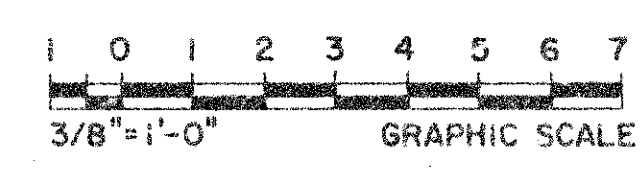

REV 2	AS-BUILT	OK	DLH	11/16/91
REV 1	AMENDMENT #1	OK	DLH	6-7-88
REV 0	ISSUED FOR BID	OK	DLH	4-18-88
REV	DESCRIPTION	DMJM	CEBAF	
SURA Southeastern Universities Research Association, Inc. 12070 Jefferson Avenue Newport News, Virginia 23606				
CONTINUOUS ELECTRON BEAM ACCELERATOR FACILITY NEWPORT NEWS VIRGINIA				
DANIEL, MANN, JOHNSON & MENDENHALL 1709 NEW YORK AVENUE N.W. WASHINGTON D.C. 20006				
SUBMITTED-DMJM	RECOMM - CEBAF	APPROVED - SURA		
FACILITY				
ACCELERATOR FACILITY				
DRAWING JUNCTION CHAMBERS SECTIONS AND DETAILS				
SCALE 3/8"=1'-0"				S-210
DWG. NO. 88-S-8-0373-103				