




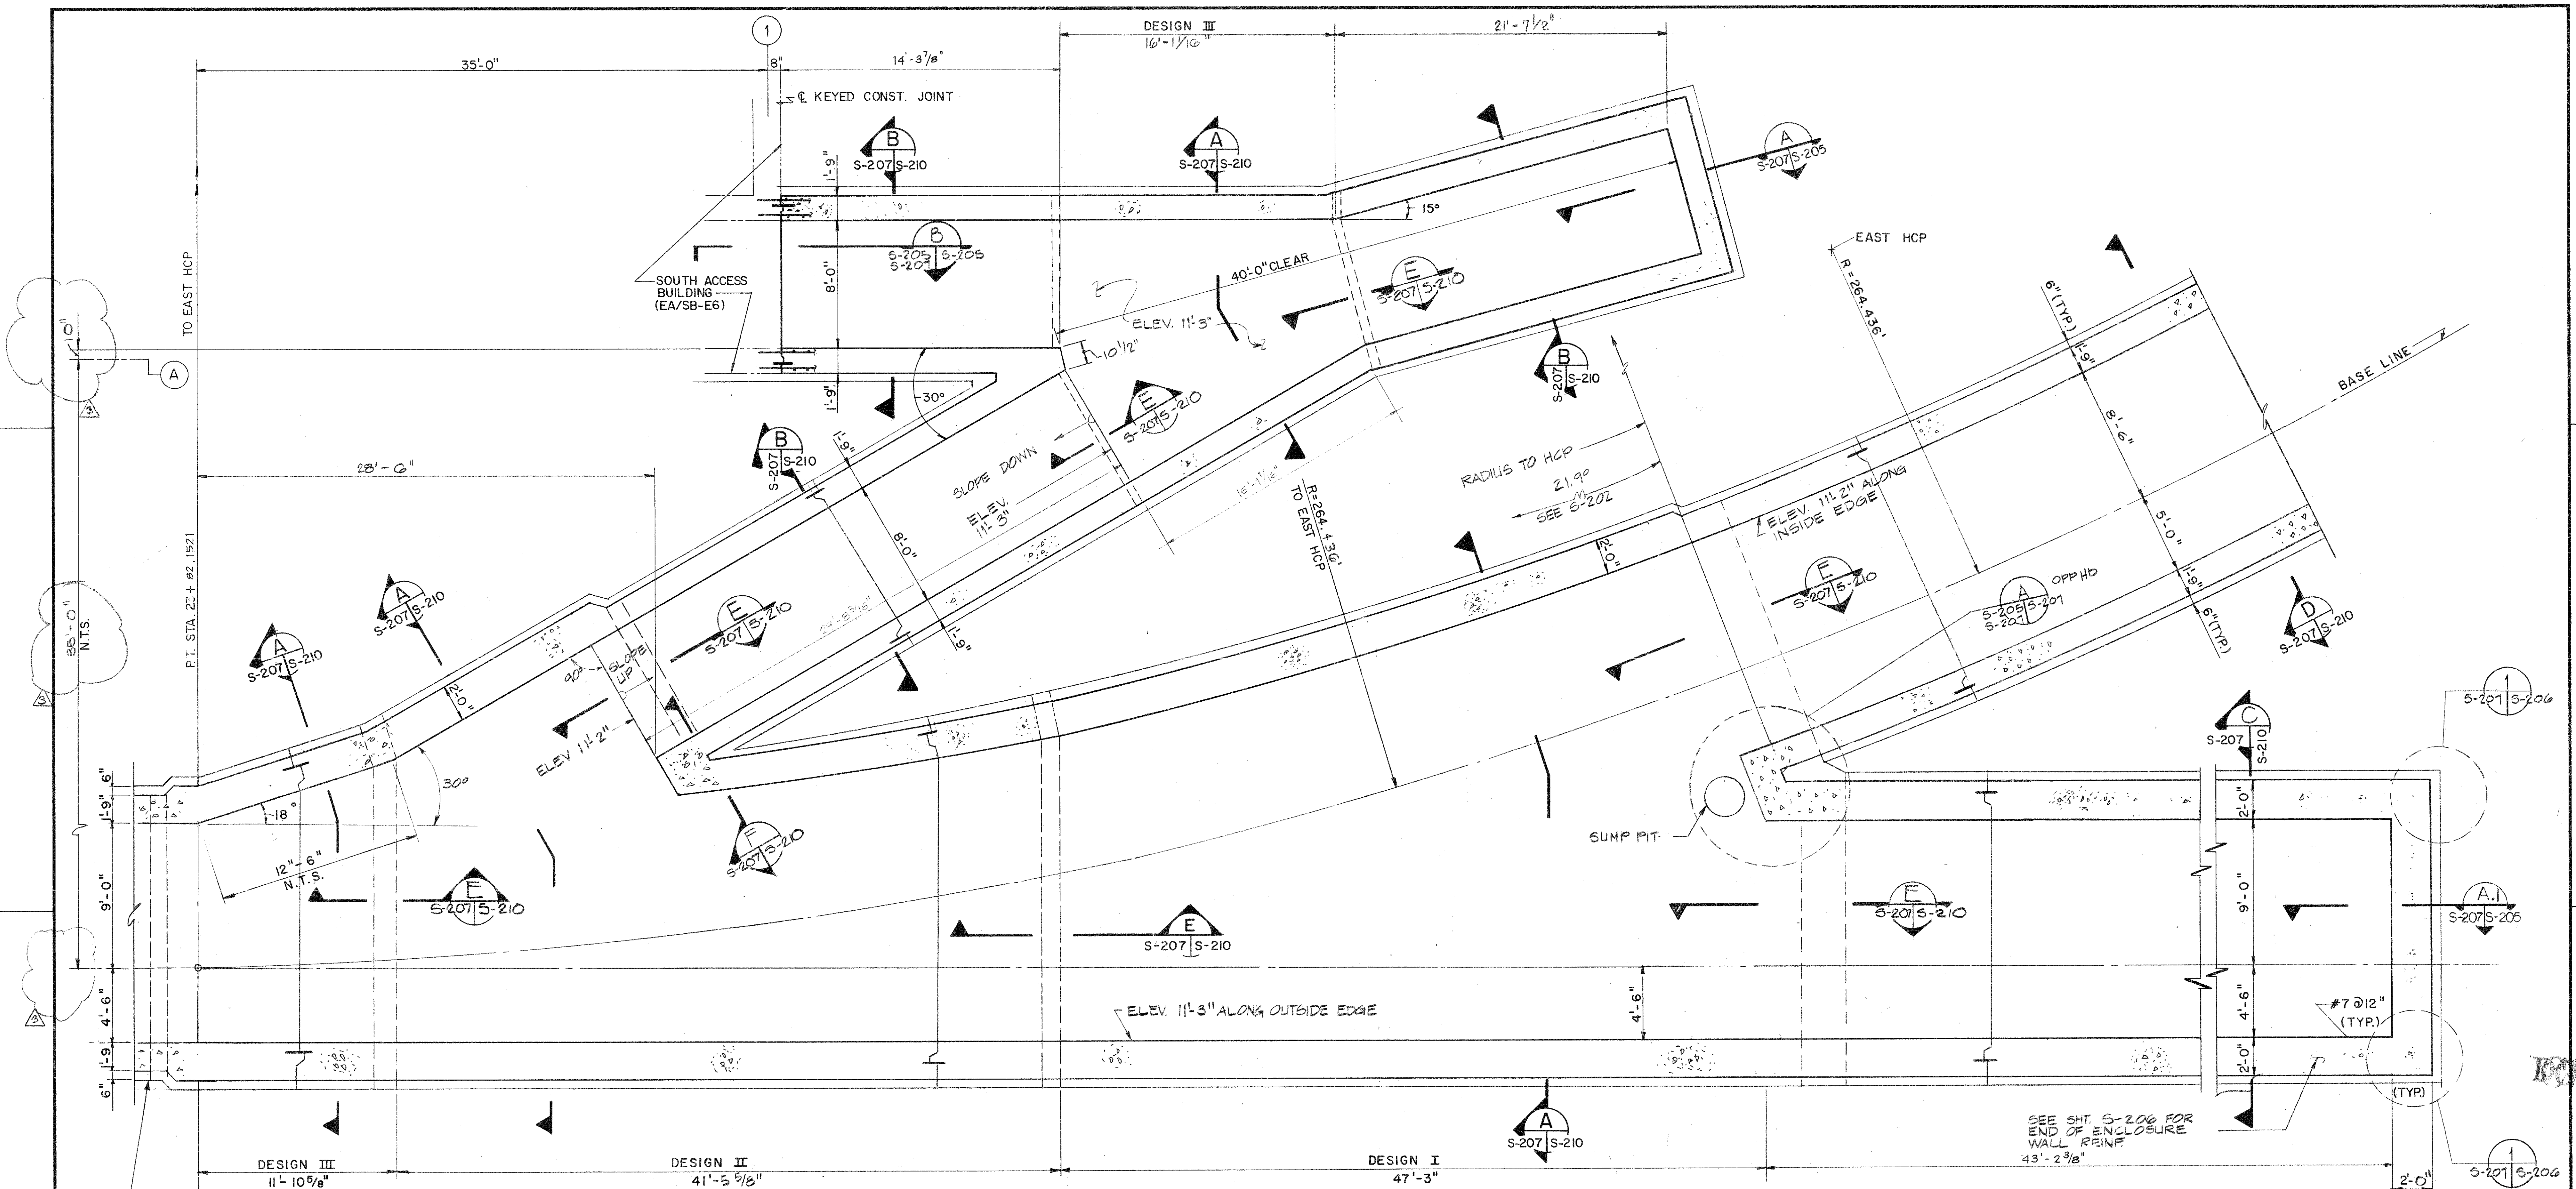


SOUTH LINAC BEAM ENCLOSURE SEE DETAILS 1 & 3 DWG. NO.

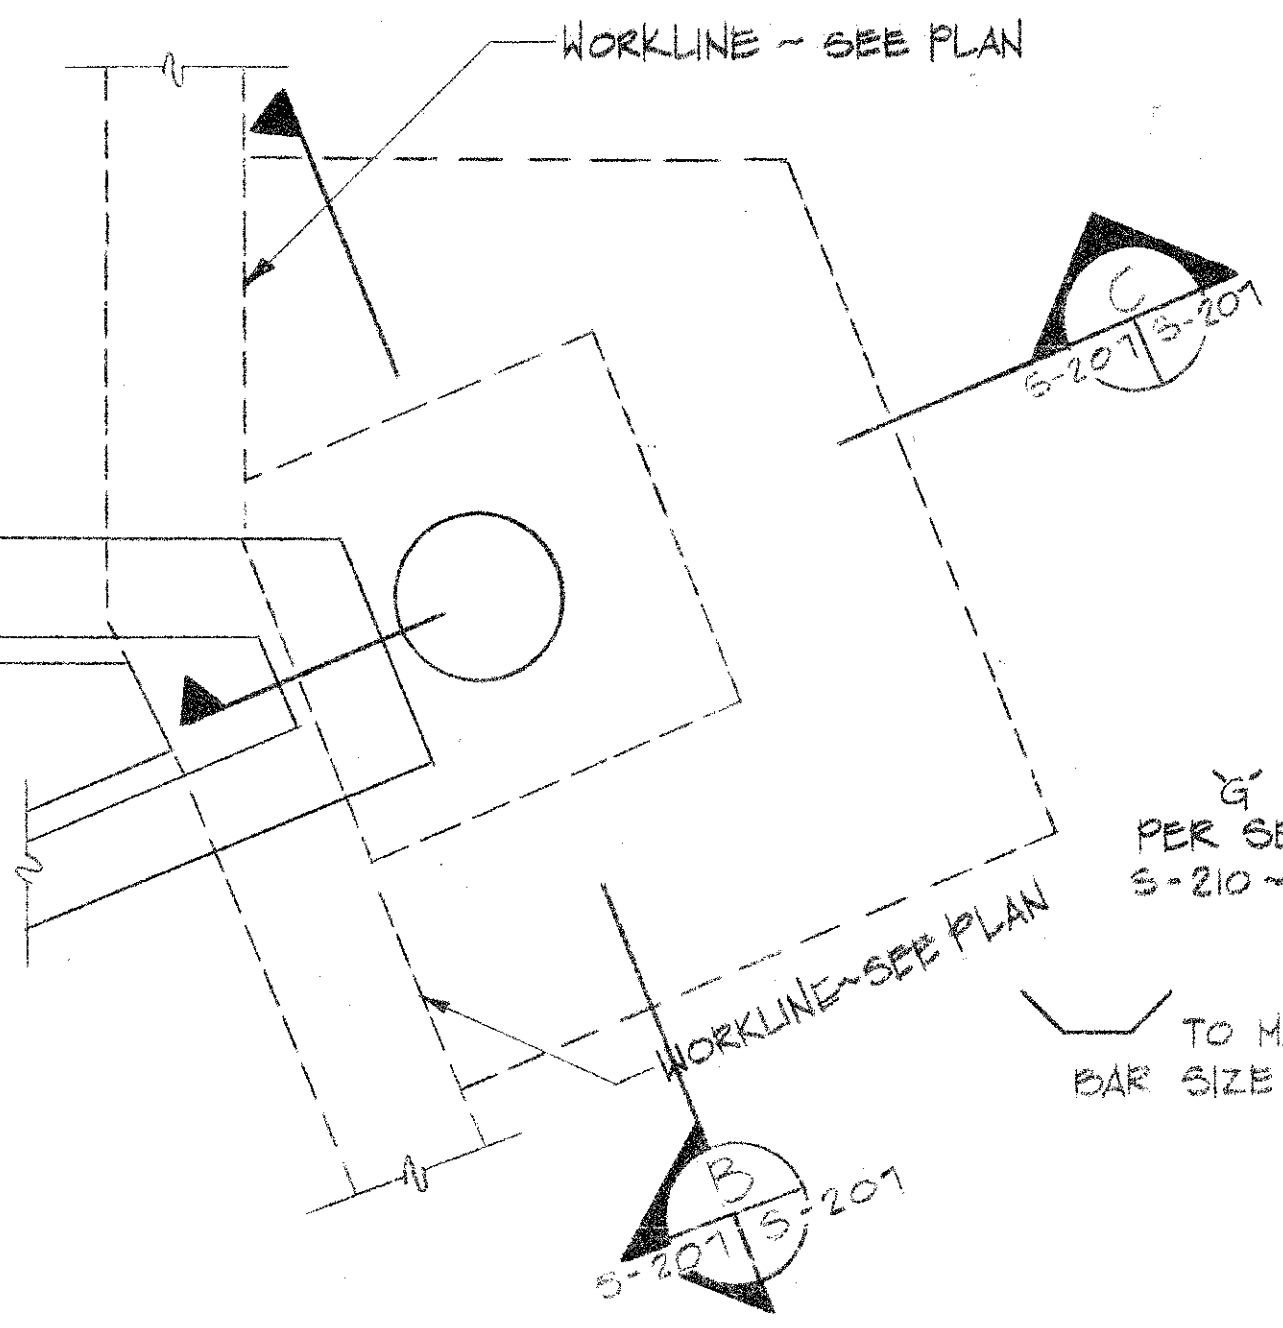

A PART PLAN
S-207/S-201 SCALE: 1/4" = 1'-0"

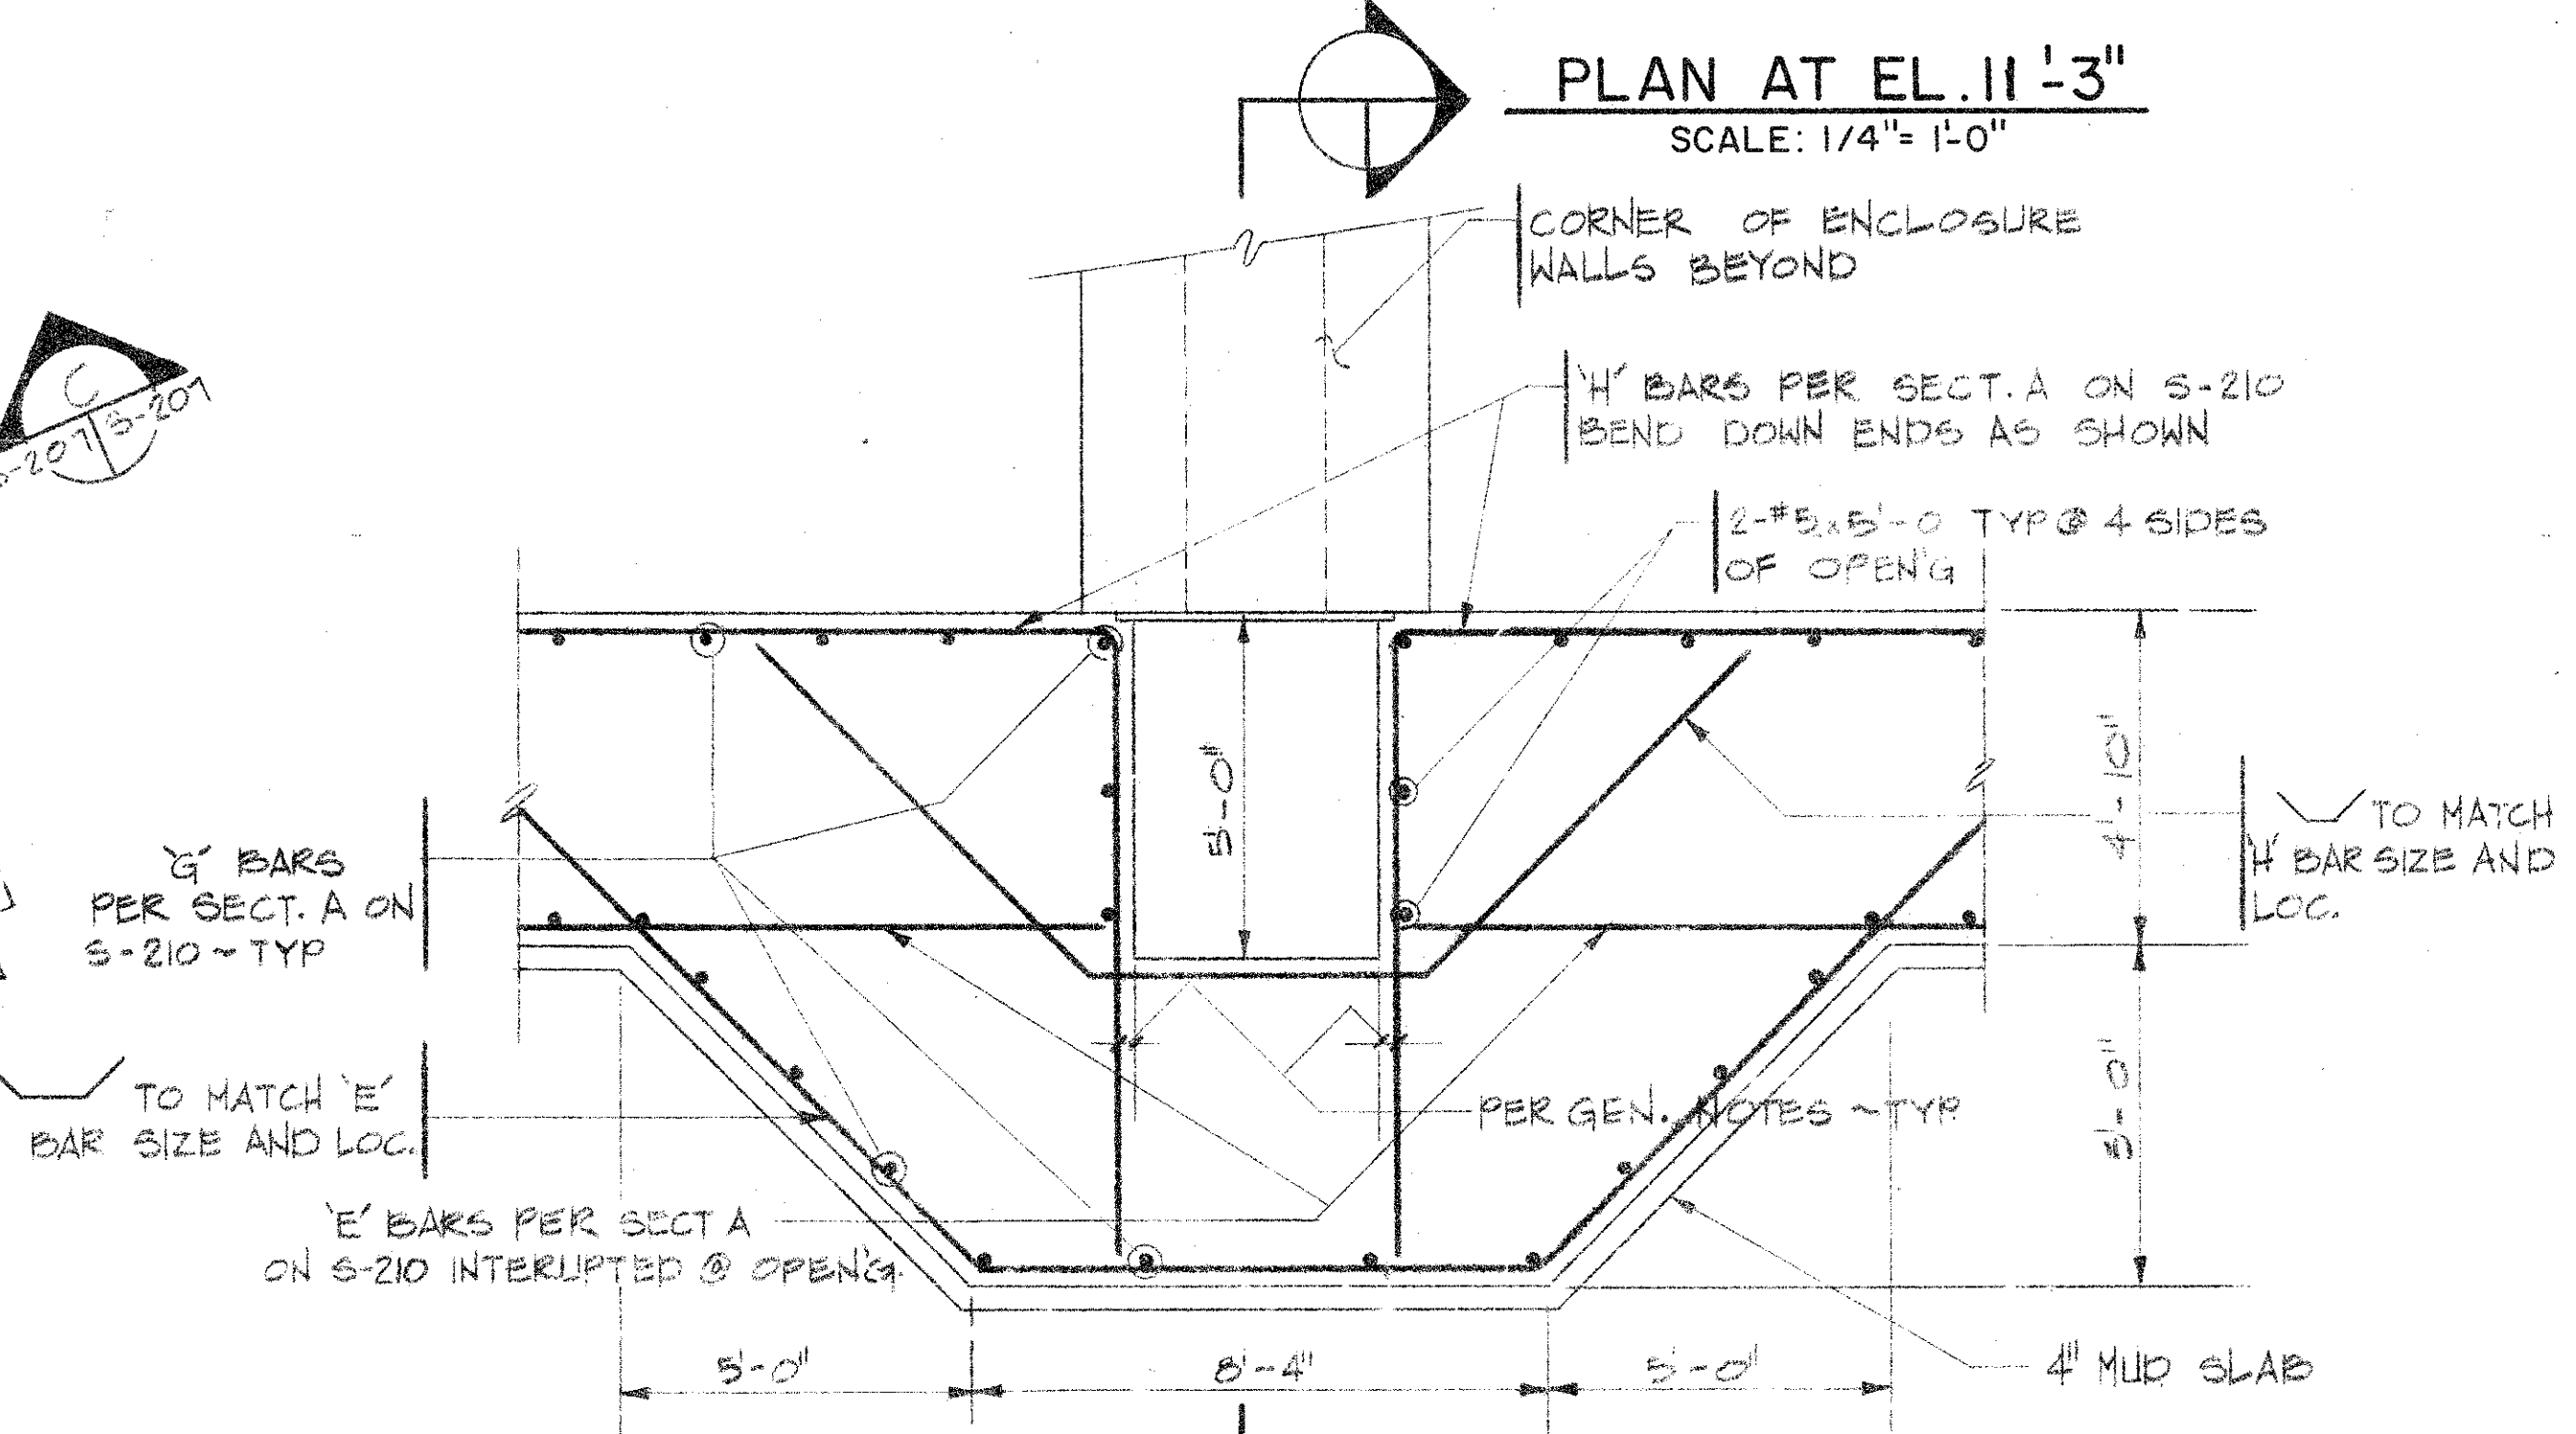


B SUMP PIT DETAIL
S-207/S-201 SCALE: 3/8" = 1'-0"

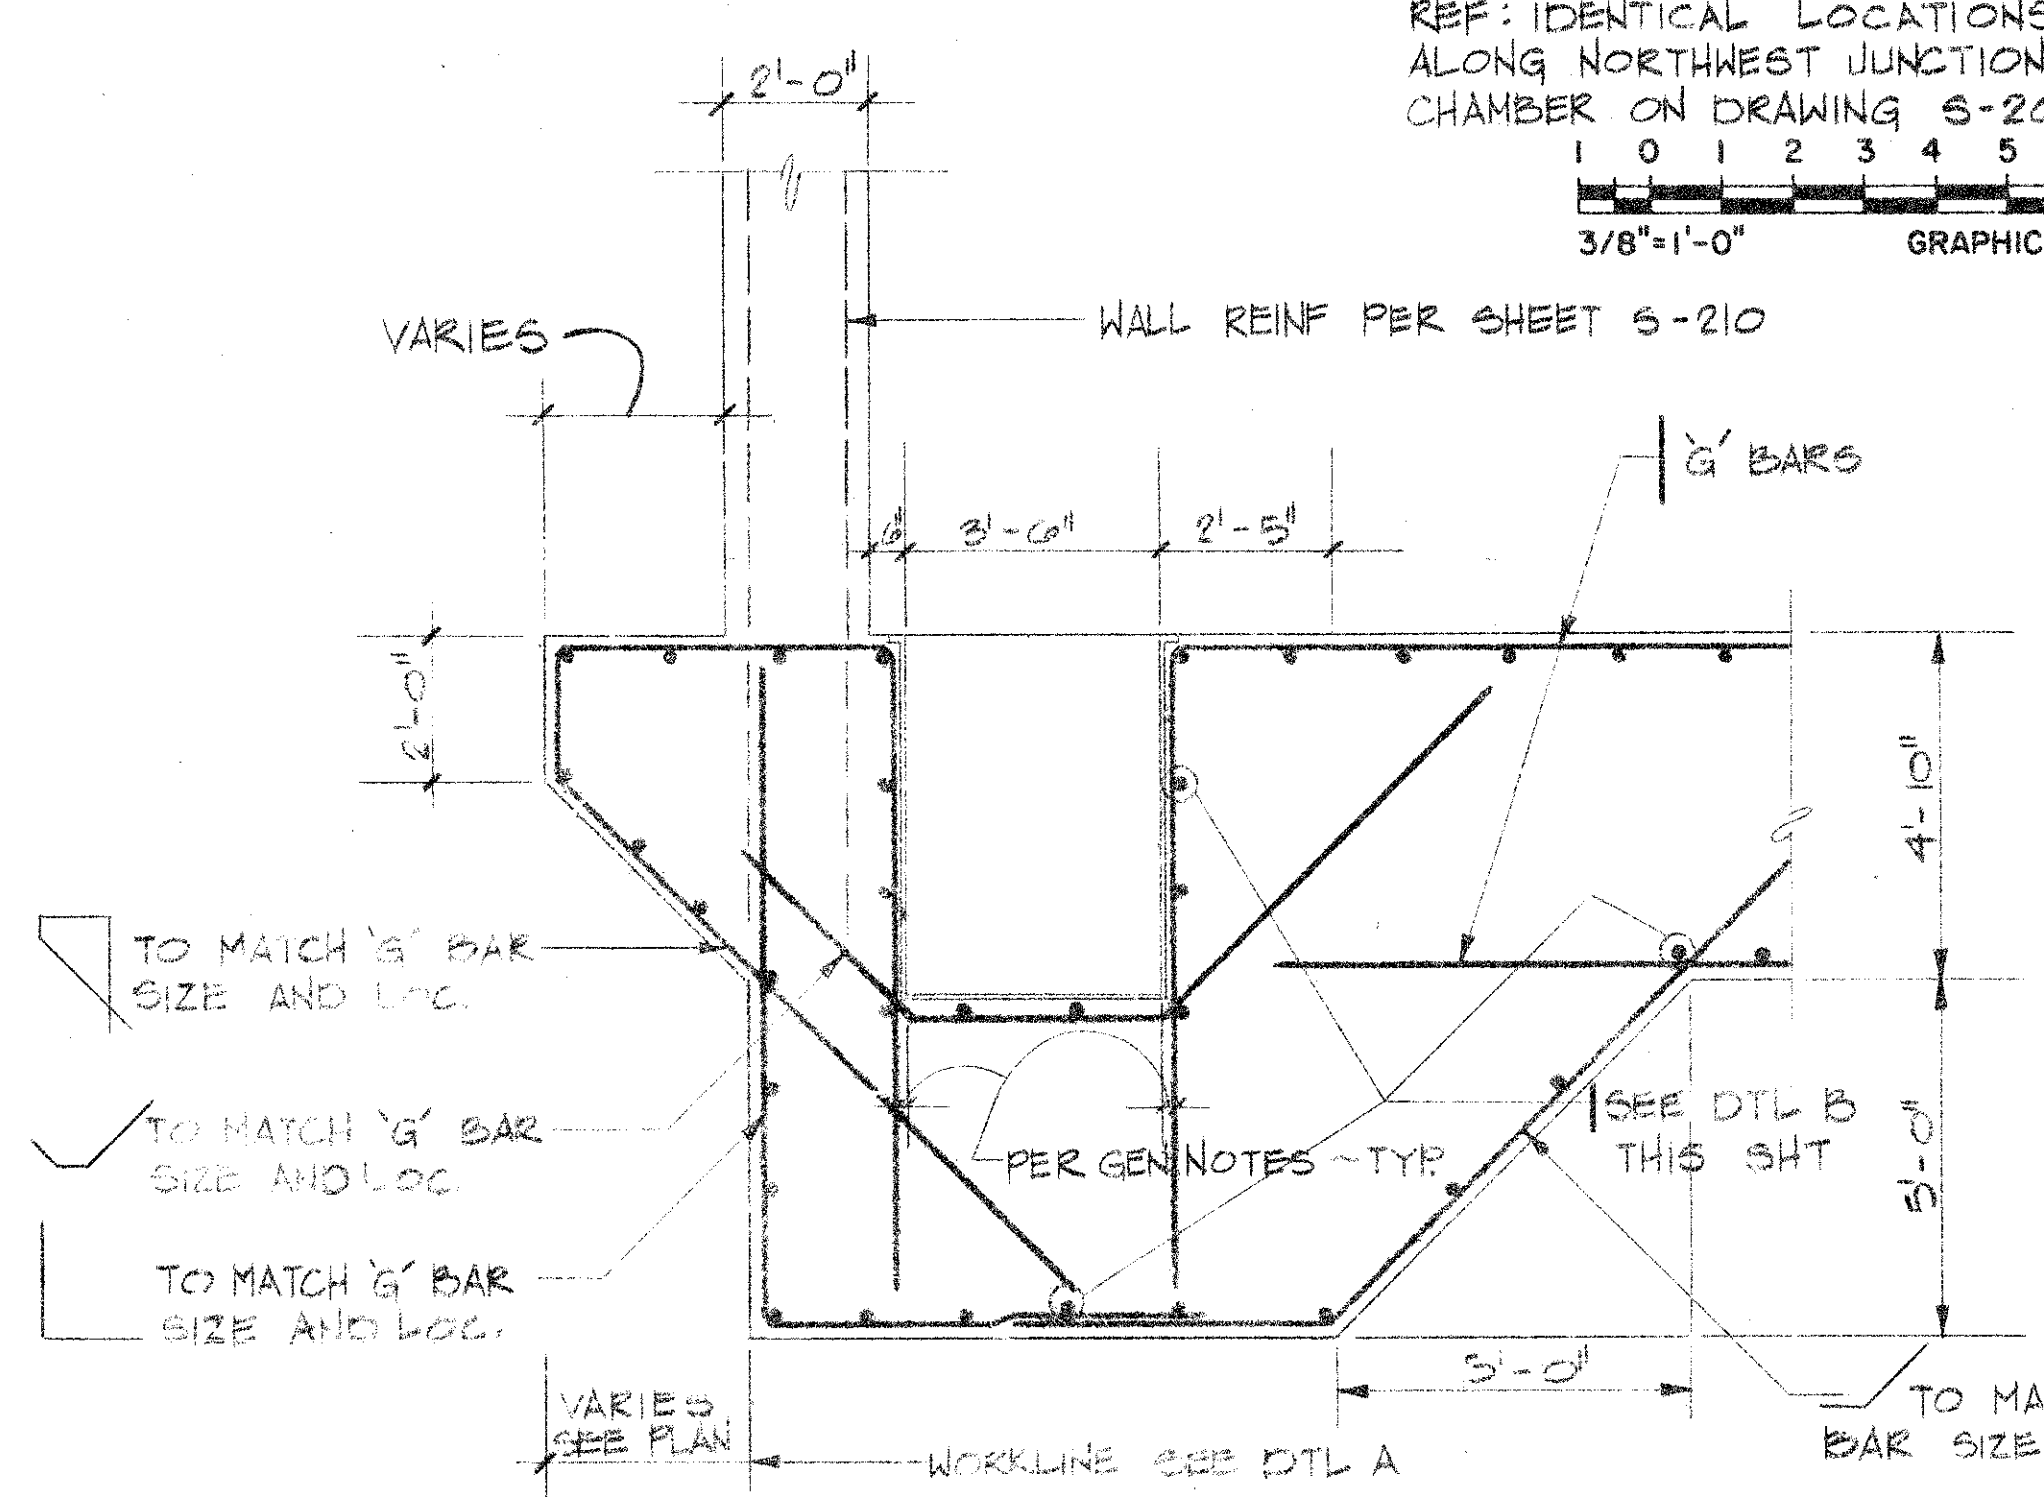

C SUMP PIT DETAIL
S-207/S-201 SCALE: 3/8" = 1'-0"

NOTES: 1. FOR DETAIL OF REINF NOT SHOWN REF: IDENTICAL LOCATIONS ALONG NORTHWEST JUNCTION CHAMBER ON DRAWING S-205-TYP U.N.O.

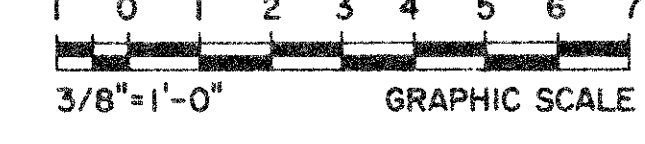

REV. 4	AS-BUILT	DMJM	CEBAF	11/15/92
REV. 3	DIMENSIONAL VERIFICATION	DMJM	CEBAF	9-27-88
REV. 2	DIMENSIONAL VERIFICATION	DMJM	CEBAF	6-7-98
REV. 1	AMENDMENT #1	DMJM	CEBAF	4-18-98
REV. 0	ISSUED FOR BID	DMJM	CEBAF	
REV.	DESCRIPTION	DMJM	CEBAF	

SURA Southeastern Universities Research Association, Inc.
12070 Jefferson Avenue
Newport News, Virginia 23606

CONTINUOUS ELECTRON BEAM ACCELERATOR FACILITY
NEWPORT NEWS VIRGINIA

DANIEL, MANN, JOHNSON & MENDENHALL
1709 NEW YORK AVENUE N.W.
WASHINGTON D.C. 20006

SUBMITTED-DMJM RECOMM - CEBAF APPROVED -SURA

FACILITY: **ACCELERATOR FACILITY**

DRAWING: **SOUTHEAST JUNCTION CHAMBER PLAN AT BEAM LEVEL**

SCALE: 1/4" = 1'-0"

DWG. NO. 88-S-8-0370-100

S-207