


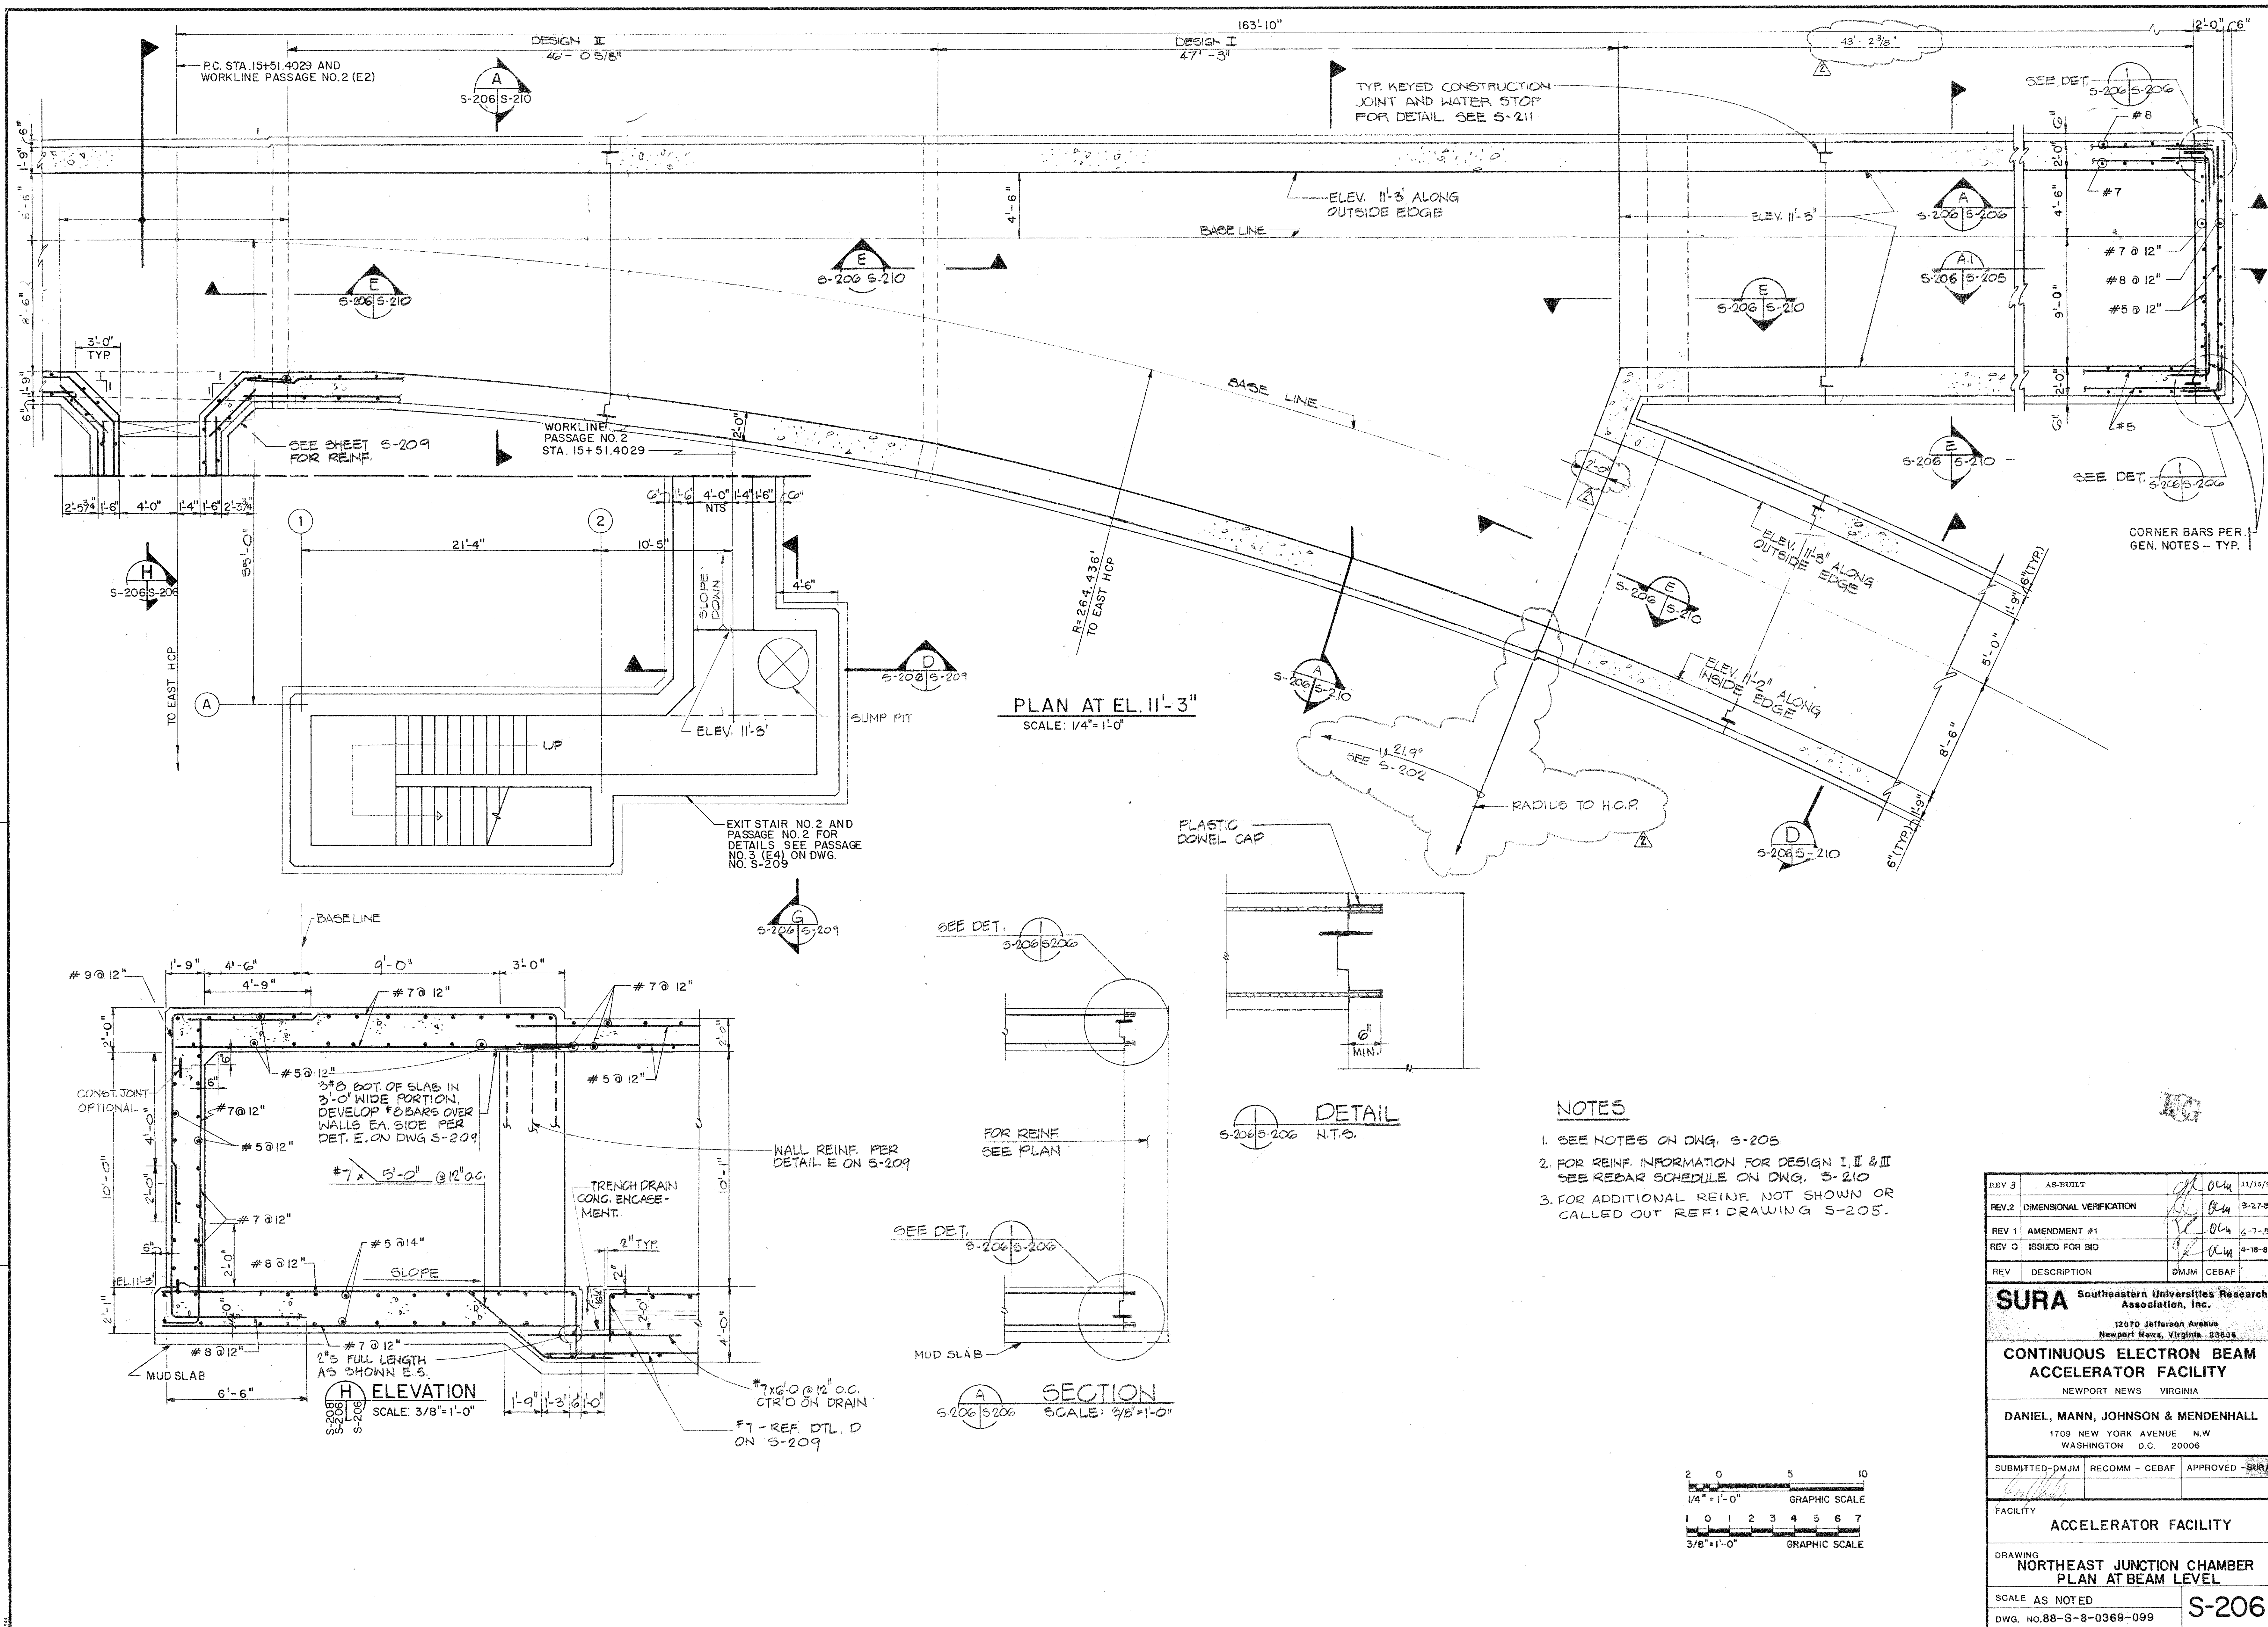

REV 3	AS-BUILT		11/16/84
REV 2	DIMENSIONAL VERIFICATION		9-2-83
REV 1	AMENDMENT #1		6-7-83
REV 0	ISSUED FOR BID		4-18-83
REV	DESCRIPTION	DMJM	CEBAF

SURA Southeastern Universities Research Association, Inc.

12070 Jefferson Avenue
Newport News, Virginia 23606

**CONTINUOUS ELECTRON BEAM
ACCELERATOR FACILITY**

NEWPORT NEWS VIRGINIA

DANIEL, MANN, JOHNSON & MENDENHALL

1709 NEW YORK AVENUE N.W.
WASHINGTON D.C. 20006

SUBMITTED-DMJM	RECOMM - CEBAF	APPROVED - SURA

FACILITY

ACCELERATOR FACILITY

DRAWING

**NORTHEAST JUNCTION CHAMBER
PLAN AT BEAM LEVEL**

SCALE AS NOTED	S-206
DWG. NO. 88-S-8-0369-099	